

DEC 1 10 03 AM '94

SURVEY & REMONUMENTATION

LAND CORNER RECORDATION CERTIFICATE
Filing Requirement of Act 74, Mich. P.A. 1970

REGISTER OF DEEDS
Ingham County, Michigan

For corners in

INGHAM (County)

APR 10 1995

COMMISSION

located in:

Corner Code ~~4~~

ONONDAGA TOWNSHIP

- 1. Public Land Survey T 1NR 2W I-10
- T _____ R _____
- T _____ R _____
- T _____ R _____
- 2. Property Controlling S _____ T _____ R _____
- in Section S _____ T _____ R _____
- 3. Miscellaneous S _____ T _____ R _____
- Property in Sec. S _____ T _____ R _____

Register of Deeds Stamp & File Number

- 4. Lot No. _____, Recorded Plat _____
- 5. Private Claims _____

	A	B	C	D	E	F	G	H	I	J	K	L
2	6	5	4	3	2	1						
3												
4	7	8	9	10	11	12						
5												
6	18	17	16	15	14	13						
7												
8	19	20	21	22	23	24						
9												
10	30	29	28	27	26	25						
11												
12	31	32	33	34	35	36						
13												

I, RONALD L. ENGER in a field survey on SEPTEMBER 9, 1994, do hereby certify that under requirements of P.A. 74, Michigan P.A. of 1970, the corner points mentioned in lines 1 and 2 above were in conformance with regulations and rules therefore as required in the current manual of survey instructions of the United States Department of the Interior, Bureau of Land Management or by a decree of a Court of Law and/or that the corner points mentioned in lines 3, 4 and 5 above were in conformance with the rules of the Michigan Board of Land Surveyors or by a Decree of a Court of Law; established, re-established, monumented, re-monumented, recovered, found as expressed below:

NOTE: Not more than 4 corners, all in the same town and range, may be recorded on this certificate.

A. Description of original monument and accessories and/or subsequent restoration:


- 1. POST SET IN ORIGINAL GOVERNMENT SURVEY BY HERVEY PARKE, DEPUTY SURVEYOR, ON DECEMBER 27, 1825, WITH THE FOLLOWING WITNESSES:
W. OAK 20 S7W 32 (21.1')
DO. 16 N23W 37 (24.4')

2. ANSON JACKSON, CO. SURVEYOR, USED CORNER IN OCTOBER 1854.

CONTINUED ON BACK

B. Description of corner evidence found and/or method applied in restoring or reestablishing corner:

SEARCHED AT APPARENT LOCATION OF CORNER AND FOUND L. BRYAN BAR & CAP AT NORTH EAST SIDE OF RAILROAD TIE FENCE POST. ACCEPTED CORNER AND REPLACED WITH STANDARD MARKER FOR PA 345 REMONUMENTATION IN INGHAM COUNTY. MEASURED NORTH 2643.59 TO I-9. MEASURED SOUTH 2629.96 TO I-11. MEASURED EAST 2617.07 TO J-10. MEASUREMENTS ARE FROM TRAVERSES RUN DURING SUPERCONDUCTING SUPER COLLIDER PROJECT OF 1988.

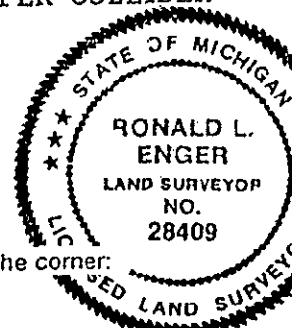

C. Description of monument for corner and accessories established to perpetuate locating the position of the corner:

I-10 T1N R2W
3/4" DIAMETER BY 24" LONG SMOOTH STEEL BAR AND CAP IMPRINTED "PA 345 PS 28409"
SET 20D GALV. SPIKE & TAG PS 28409 IN WEST SIDE OF 12" PINE, 305° AZ., 47.77'
SET 20D GALV. SPIKE & TAG PS 28409 IN NORTH SIDE OF 14" ELM, 126° AZ. 4.58'
SOUTHWEST CORNER HOUSE FOUNDATION, 330° AZ., 85.09'
FOUND NAIL & TAG PS 25832 IN EAST SIDE 60" ELM, 358° AZ., 25.35'
CORNER IS 1' SOUTHWEST OF UTILITY POLE

Signed by Ronald L. Enger Date NOVEMBER 9, 1994

I-10 T1N R2W
PART A CONTINUED

3. L. BRYAN, LS 25832, RECORDED CORNER (LIBER 6 OF CORNERS, PAGE 230) IN FEB. 1983 "FOUND ANCHOR POST ON EAST-WEST FENCE LINE, EXCAVATED AROUND POST AND FOUND NO EVIDENCE OF CORNER. LONG TIME RESIDENT OF PROPERTY TO NORTH HAS ALWAYS ACCEPTED POST AS BEING PROPERTY LINE WITH ADJOINING LAND OWNERS. ACCEPTED POST AS CORNER AND SET $\frac{1}{2}$ " BAR WITH CAP."

$\frac{1}{2}$ " BAR AND CAP SET AT ANCHOR POST.

SET NAIL AND TAG E. SIDE 36" ELM NORTH 25.12'

SET NAIL AND TAG N. SIDE 12" ELM EAST 29.90'

SW CORNER OF HOUSE N30°W 85.00'

4. R. HELSEL, LS 18994, USED CORNER IN MAY 1992 (LIBER 6 OF SURVEYS, PAGE 1149) WITH SAME MONUMENT AND WITNESSES AS ITEM #3 AND RECORDED IT AT SAME TIME (LIBER 7 OF CORNERS, PAGE 319)