

DEC 1 10 03 AM '94

SURVEY & REMONUMENTATION

LAND CORNER RECORDATION CERTIFICATE  
Filing Requirement of Act 74, Mich. P.A. 1970

For corners in

INGHAM (County)

APR 10 1995

REGISTER OF DEEDS  
INGHAM COUNTY, MICH.

Located in: \_\_\_\_\_ Corner Code ~~##~~

1. Public Land Survey T 1N R 2W I-11

T \_\_\_\_\_ R \_\_\_\_\_

T \_\_\_\_\_ R \_\_\_\_\_

T \_\_\_\_\_ R \_\_\_\_\_

2. Property Controlling S \_\_\_\_\_ T \_\_\_\_\_ R \_\_\_\_\_

In Section S \_\_\_\_\_ T \_\_\_\_\_ R \_\_\_\_\_

3. Miscellaneous S \_\_\_\_\_ T \_\_\_\_\_ R \_\_\_\_\_

Property in Sec. S \_\_\_\_\_ T \_\_\_\_\_ R \_\_\_\_\_

Register of Deeds Stamp & File Number

4. Lot No. \_\_\_\_\_, Recorded Plat \_\_\_\_\_
5. Private Claims \_\_\_\_\_

	A	B	C	D	E	F	G	H	I	J	K	L
2	1	2	3	4	5	6	7	8	9	10	11	12
3	13	14	15	16	17	18	19	20	21	22	23	24
4	25	26	27	28	29	30	31	32	33	34	35	36
5												
6												
7												
8												
9												
10												
11												
12												
13												

I, RONALD L. ENGER in a field survey on SEPTEMBER 9, 1994, do hereby certify that under requirements of P.A. 74, Michigan P.A. of 1970, the corner points mentioned in lines 1 and 2 above were in conformance with regulations and rules therefore as required in the current manual of survey instructions of the United States Department of the Interior, Bureau of Land Management or by a decree of a Court of Law and/or that the corner points mentioned in lines 3, 4 and 5 above were in conformance with the rules of the Michigan Board of Land Surveyors or by a Decree of a Court of Law; established, re-established, monumented, re-monumented, recovered, found as expressed below:


NOTE: Not more than 4 corners, all in the same town and range, may be recorded on this certificate.

A. Description of original monument and accessories and/or subsequent restoration:

- POST SET IN ORIGINAL GOVERNMENT SURVEY BY HERVEY PARKE, DEPUTY SURVEYOR, ON DECEMBER 25, 1825 WITH THE FOLLOWING WITNESSES:  
B. OAK 20 S31E .21 (13.9')  
HICKORY 20 N22E .15 (9.9')
- A. JACKSON, CO. SURVEYOR, USED CORNER IN APRIL 1853 RECORDED IN VOL 2, PAGE 156 WITH SAME MONUMENT AND WITNESSES AS IN ITEM 1.

B. CONTINUED ON BACK  
Description of corner evidence found and/or method applied in restoring or reestablishing corner:

SEARCHED AT APPARENT LOCATION OF CORNER AND FOUND CONCRETE MONUMENT IN MON BOX ON CENTERLINE OLDS ROAD AND PROVED IT TO BE IN THE POSITION RECORDED BY R. LESTER BY THE HICKORY WITNESS IN THE SOUTHWEST QUADRANT. ACCEPTED MONUMENT AS PERPETUATION OF CORNER AND LEFT IT IN PLACE AND CAPPED IT WITH STANDARD PA 345 CAP.

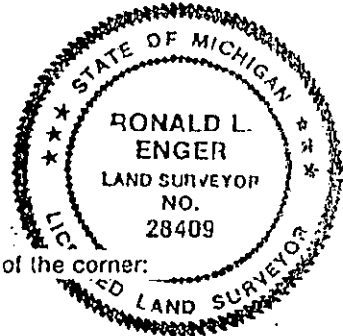

C. Description of monument for corner and accessories established to perpetuate locating the position of the corner:

I-11 T1N R2W  
4" DIAMETER CONCRETE AND REBAR MONUMENT WITH CAP IMPRINTED "PA 345 PS 28409" IN MONUMENT BOX ON CENTERLINE OLDS ROAD  
NAIL & TAG LS 25832 IN NORTH SIDE 8" HICKORY, 132° NAZ, 37.06'  
TOP CENTER OF BEEHIVE CATCH BASIN, 250° NAZ, 50.90'  
NAIL & TAG LS 18998 IN NORTH SIDE 23" HICKORY, 256° NAZ, 79.61'  
20D GALV SPIKE & TAG PS 28409 IN SOUTH SIDE UTILITY POLE, 51° NAZ, 91.08'

Signed by Ronald L. Enger Date OCTOBER 31, 1994

Surveyor's Michigan License No. 28409

2756

P.A. 345 INGHAM COUNTY  
PEER APPROVED 11/09/94

I-11 TIN R2W  
PART A CONTINUED

3. A.P. DRAKE, CO. SURVEYOR, USED CORNER IN A SURVEY IN MARCH 1880 (VOL 3, PAGE 167)  
AND NOVEMBER 1881 (VOL 3, PAGE 183)  
STONE AND CROCKERY  
HICK 15 S70½E 112½ (74.25')

4. WM. BERRYMAN, COUNTY SURVEYOR, WITNESSED CORNER 1/27/32 IN HIS PRIVATE RECORDS  
STONE AND CROCKERY  
HICK 20" NE 22'  
ELM 24" ESE 117'

5. INGHAM COUNTY ROAD COMMISSION -- GRID MAP  
SAME MON AND WITNESSES AS ITEM 4.

6. R. LESTER, LS 18998, RECORDED CORNER (LIBER 4 OF CORNERS, PAGE 326) IN AUGUST 1978,  
DURING THE INGHAM COUNTY SURVEY AND REMONUMENTATION PROJECT OF THE LATE 1970'S  
AS A CONCRETE MONUMENT IN CONCRETE COLLAR SET IN PLACE OF A LONG POINTED STONE  
AND CROCKERY FOUND BY EXCAVATION.

NAIL AND TAG #18998 E. SIDE 16" HICKORY, NNE, 21.31'  
NAIL AND TAG #18998 E. SIDE 10" TWIN WALNUT, SOUTH, 30.73'  
NAIL AND TAG #18998 E. SIDE 8" WILD CHERRY, SSE, 40.09'  
NAIL AND TAG #18998 N. SIDE TRIPLE HICKORY, WSW, 79.46'

7. R. HELSEL, LS 18994, USED CORNER IN MAY 1992 (LIBER 6 OF SURVEYS, PAGE 1149)  
CONCRETE MONUMENT

NAIL AND TAG N. SIDE 4" HICKORY SE 37.05'  
NAIL AND TAG N. SIDE 16" HICKORY WSW 79.58'