

DEC 1 10 04 AM '94

REGISTER OF DEEDS
INGHAM COUNTY, MICH.

SURVEY & REMONUMENTATION

LAND CORNER RECORDATION CERTIFICATE

Filing Requirement of Act 74, Mich. P.A. 1970

For corners of

INGHAM

(County)

Located In:

Corner Code #

ONONDAGA TOWNSHIP

APR 10 1995
COMMISSION

- 1. Public Land Survey T 1N R 2W Corner Code # J-9
- T _____ R _____
- T _____ R _____
- T _____ R _____
- 2. Property Controlling in Section S _____ T _____ R _____
- S _____ T _____ R _____
- 3. Miscellaneous Property in Sec. S _____ T _____ R _____
- S _____ T _____ R _____

Register of Deeds Stamp & File Number

4. Lot No. _____, Recorded Plat _____

5. Private Claims _____

	A	B	C	D	E	F	G	H	I	J	K	L
2	6	5	4	3	2	1						
3												
4	7	8	9	10	11	12						
5												
6	18	17	16	15	14	13						
7												
8	19	20	21	22	23	24						
9												
10	30	29	28	27	26	25						
11												
12	31	32	33	34	35	36						
13												

I, RONALD L. ENGER, in a field survey on SEPTEMBER 2, 19 94, do hereby certify that under requirements of P.A. 74, Michigan P.A. of 1970, the corner points mentioned in lines 1 and 2 above were in conformance with regulations and rules (hereinafter as required in the current manual of survey instructions of the United States Department of the Interior, Bureau of Land Management or by a decree of a Court of Law and/or that the corner points mentioned in lines 3, 4 and 5 above were in conformance with the rules of the Michigan Board of Land Surveyors or by a Decree of a Court of Law; established, re-established, monumented, re-monumented, recovered, found as expressed below:

NOTE: Not more than 4 corners, all in the same town and range, may be recorded on this certificate.

A. Description of original monument and accessories and/or subsequent restoration:


- 1. POST SET IN ORIGINAL GOVERNMENT SURVEY BY HERVEY PARKE, DEPUTY SURVEYOR, ON DECEMBER 25, 1825, WITH THE FOLLOWING WITNESSES:
W.O. 16 N19W 14 (9.2')
W.O. 12 S80E 8 (5.3')
- 2. T.J. BROWN, DEP. CO. SURVEYOR, USED CORNER IN SEPT. 1872 (VOL 3, PAGE 63)
POST
W.O. 12 N13&5/6W 112 (73.9')
W.O. 16 N19W 14 (GONE) CONTINUED ON BACK

B. Description of corner evidence found and/or method applied in restoring or reestablishing corner:

SEARCHED AT APPARENT LOCATION OF CORNER AND FOUND 1 1/4" WELL POINT 6.5' NORTH OF PHYSICAL CENTERLINE OF BELLEVUE ROAD ON OCCUPATION LINE NORTH AND SOUTH. ALL OF R. HELSEL'S WITNESSES OF 1975 AND B. ANTCLIFF'S WITNESSES OF 1988 ARE STILL STANDING. EXCAVATED AROUND WELLPOINT TO A DEPTH OF 3 FEET AND FOUND NOTHING MORE. COULD NOT REMOVE OR EVEN MOVE WELLPOINT. ACCEPTED WELLPOINT AS PERPETUATION OF CORNER PER INGHAM COUNTY ROAD COMMISSION WITNESSES AND CAPPED IT WITH PA 345 CAP AND SET MONUMENT BOX. MEASURED EAST 2638.48 TO K-9. MEASURED SOUTH 2640.92 TO J-10. MEASURED WEST 2630.80 TO I-9. MEASUREMENTS ARE FROM TRAVERSE RUN DURING SUPERCONDUCTING SUPER COLLIDER PROJECT 1988.

C. Description of monument for corner and accessories established to perpetuate locating the position of the corner:

J-9 T1N R2W
1 1/4" WELLPOINT WITH PA 345 CAP PS 28409 IN MONUMENT BOX
WEST EDGE OF 6" X 6" ANGLE IRON FENCE POST, 14° NAZ, 26.37'
EAST EDGE OF 6" X 6" ANGLE IRON FENCE POST, 45° NAZ, 36.22'
EAST EDGE OF 6" X 6" ANGLE IRON FENCE POST, 68° NAZ, 55.68'
NAIL & TAG 18998, (R. LESTER) IN NORTHEAST SIDE UTILITY POLE, 144° NAZ, 104.91'
NAIL & TAG 18998 IN NORTH SIDE 40" OAK, 106° NAZ, 300.80'
CORNER IS 6.5' NORTH OF THE CENTERLINE OF BELLEVUE ROAD

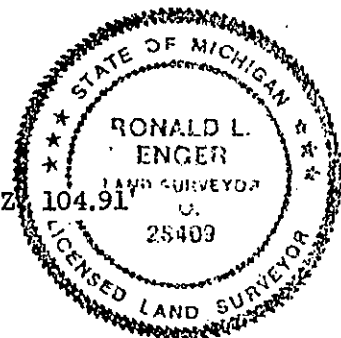

Signed by Ronald L. Enger Date OCTOBER 31, 1994

Surveyor's Michigan License No. 28409

2757

P.A. 345 INGHAM COUNTY
FORM APPROVED BY MICHIGAN STATE BOARD OF LAND SURVEYORS, JAN. 28, 1977
REVISED MAY 14, 1977
REVISED JAN., 1984
PEER APPROVED 11/01/94 ML

J-9 T1N R2W
PART A CONTINUED

3. INGHAM COUNTY ROAD COMMISSION -- GRID MAP
WELL POINT
40" OAK ESE 129.0'
ANCH POST 33.0'
PUMP NNE 132.5'

4. R. HELSEL, LS 18997, RECORDED CORNER IN JAN. 1976 (LIBER 3 OF CORNERS, PAGE 511)
AND USED IN SURVEYS (LIBER 2 OF SURVEYS, PAGE 777 AND 778)
WELL POINT
ANGLE IRON GATE POST, N60°E, 55.8'
ANGLE IRON GATE POST, N20°E, 35.75'
ANGLE IRON GATE POST, N05°E, 26.3'

5. G. YOUNG, LS 17640, USED THIS CORNER IN AUG 1986 (LIBER 5 OF SURVEYS, PAGE 57) BUT
SHOWS WITNESSES TO J-9, T3N R1W.

6. BRUCE ANTCLIFF, LS 25826, USED CORNER IN OCT. 1988 (LIBER 5 OF SURVEYS, PAGE 956-
957) DURING SUPER COLLIDER PROJECT.
2" IRON PIPE
NAIL IN 40" OAK S79°E 300.80'
NAIL IN UTIL. POLE S38°E 104.90'
ANGLE IRON GATE POST N13°E 26.40'
ANGLE IRON GATE POST N48°E 35.80'

7. MAURICE MAHIEU, LS 28414, USED CORNER IN JUNE 1993 (LIBER 6 OF SURVEYS, PAGE
274) WITH REFERENCE TO LIBER 3 OF CORNERS, PAGE 511.

8. JAMES GRANGER, LS 16041, USED CORNER IN JANUARY 1994 (LIBER 7 OF SURVEYS, PAGE
31) WITH REFERENCE OF LIBER 3 OF CORNERS, PAGE 511.