

SURVEY & REMONUMENTATION

LIBER 8 PAGE 409

FILED

APR 10 1995

LAND CORNER RECORDATION CERTIFICATE
Filing Requirement of Act 74, Mich. P.A. 1970

DEC 1 10 04 AM '94

For corners in

INGHAM
(County)

Located In:

Corner Code 44

ONONDAGA TOWNSHIP

- | | | |
|------------------------------------|-------------------------|-------------|
| 1. Public Land Survey | T <u>1N</u> R <u>2W</u> | <u>J-10</u> |
| | T _____ R _____ | _____ |
| | T _____ R _____ | _____ |
| | T _____ R _____ | _____ |
| 2. Property Controlling in Section | S _____ T _____ R _____ | _____ |
| | S _____ T _____ R _____ | _____ |
| 3. Miscellaneous Property in Sec. | S _____ T _____ R _____ | _____ |
| | S _____ T _____ R _____ | _____ |

REGISTER OF DEEDS
Ronald L. Enger
INGHAM COUNTY, MICH.

Register of Deeds Stamp & File Number

4. Lot No. _____, Recorded Plat _____
5. Private Claims _____

A	B	C	D	E	F	G	H	I	J	K	L
2	6	5	4	3	2	1					
3											
4	7	8	9	10	11	12					
5											
6	16	17	16	15	14	13					
7											
8	19	20	21	22	23	24					
9											
10	30	29	28	27	26	25					
11											
12	31	32	33	34	35	36					
13											

I, RONALD L. ENGER in a field survey on SEPTEMBER 16, 1994, do hereby certify that under requirements of P.A. 74, Michigan P.A. of 1970, the corner points mentioned in lines 1 and 2 above were in conformance with regulations and rules therefor as required in the current manual of survey instructions of the United States Department of the Interior, Bureau of Land Management or by a decree of a Court of Law and/or that the corner points mentioned in lines 3, 4 and 5 above were in conformance with the rules of the Michigan Board of Land Surveyors or by a Decree of a Court of Law; established, re-established, monumented, re-monumented, recovered, found as expressed below:

NOTE: Not more than 4 corners, all in the same town and range, may be recorded on this certificate.

A. Description of original monument and accessories and/or subsequent restoration:

1. T.J. BROWN, COUNTY SURVEYOR USED CORNER IN OCT. 1858 (LIBER 2, PAGE 347)
W.O. 12 S24-3/4E 52-3/4 (34.8')
PEPPERIDGE 13 S63 1/2 E 79 (52.1')


CONTINUED ON BACK

B. Description of corner evidence found and/or method applied in restoring or reestablishing corner:

SEARCHED AT APPARENT LOCATION OF CORNER AND FOUND 1/2" BAR AND CAP LS 18998 AT NORTHWEST SIDE 4 WAY ANCHOR POST. MEASURED S 25° E, 34.8' TO 4' DIAMETER STUMP. MEASURED S 63° E, 52.1' TO 4' DIAMETER STUMP. BELIEVE THAT BOTH STUMPS ARE REMAINS OF T.J. BROWN'S WITNESSES OF 1858. ACCEPTED BAR AND CAP AS PERPETUATION OF CORNER BECAUSE OF EXACT AGREEMENT WITH HISTORICAL WITNESSES. INTERSECTION OF 1/4" LINES IS 2.72' SOUTH AND 0.10' EAST OF CORNER. REPLACED 1/2" BAR AND CAP WITH STANDARD BAR AND PA 345 CAP. MEASURED NORTH 2640.92' TO J-9. MEASURED SOUTH 2637.75' TO J-11. MEASURED EAST 2639.63 TO K-10. MEASURED WEST 2617.06 TO I-10. MEASUREMENTS ARE FROM TRAVERSES RUN DURING SUPERCONDUCTING SUPER COLLIDER PROJECT OF 1988.

C. Description of monument for corner and accessories established to perpetuate locating the position of the corner:

- J-10 T1N R2W
3/4" BY 24" LONG SMOOTH STEEL BAR AND PA 345 CAP PS 28409
NAIL AND TAG 18998 IN EAST SIDE 15" OAK, NAZ 173°, 26.50'
NAIL AND TAG 18998 IN NORTH SIDE 14" OAK, NAZ 284°, 10.53'
NAIL AND TAG 18998 IN NORTH SIDE 12" CHERRY, NAZ 69°, 29.24'
NAIL AND TAG 18998 IN WEST SIDE 17" OAK, NAZ 13°, 55.09'
NAIL AND TAG 28414 (M. MAHIEU) IN NORTH SIDE 20" MAPLE, NAZ 124°, 25.10'

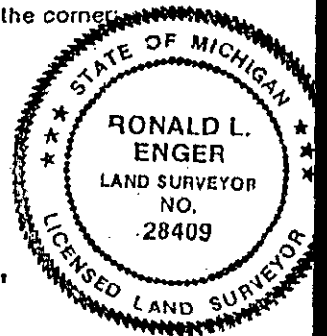

Signed by Ronald L. Enger Date NOVEMBER 04, 1994

Surveyor's Michigan License No. 28409 P.A. 345 INGHAM COUNTY FORM APPROVED BY MICHIGAN STATE BOARD OF LAND SURVEYORS, JAN. 28, 1977
2758 PEER APPROVED 11/09/94 M REVISED MAY 14, 1977
REVISED JAN., 1988

J-10 T1N R2W
PART A CONTINUED

2. RONNIE LESTER, LS 18998, RECORDED CORNER IN NOV. 1988 (LIBER 7 OF CORNERS PAGE 40)
AS A $\frac{1}{2}$ " BAR AND CAP SET AT NW SIDE FOUR-WAY ANCHOR POST.
NAIL AND TAG N. SIDE 12" RED OAK, 283°AZ, 10.6'
NAIL AND TAG N. SIDE 12" CHERRY, 69°AZ, 29.2'
NAIL AND TAG E. SIDE 14" RED OAK, 173°AZ, 26.4'
NAIL AND TAG W. SIDE 24" OAK, 13°AZ, 55.1'
NAIL AND TAG S. SIDE 40" OAK, 273°AZ, 85.6'
3. MAURICE MAHIEU, LS 28414, USED CORNER IN MAY, 1993 (LIBER 6 OF SURVEYS, PAGE 1258)
WITH SAME MONUMENT AND WITNESSES AS ITEM 3.
4. J GRANGER, LS 16041, USED CORNER IN JANUARY 1994 WITH REFERENCE TO LIBER 7 OF
CORNERS, PAGE 40.

2758