

**SURVEY & REMONUMENTATION**  
**APR 10 1995**  
**COMMISSION**

DEC 1 10 04 AM '94

**LAND CORNER RECORDATION CERTIFICATE**  
 Filing Requirement of Act 74, Mich. P.A. 1970

REGISTER OF DEEDS  
*Ronald L. Enger*  
 INGHAM COUNTY, MICH.

For corners in  
**INGHAM**  
 (County)  
**ONONDAGA TOWNSHIP**

Located In: Corner Code #

1. Public Land Survey	T	<u>1N</u>	R	<u>2W</u>	<u>J-11</u>	
	T	_____	R	_____	_____	
	T	_____	R	_____	_____	
	T	_____	R	_____	_____	
2. Property Controlling In Section	S	_____	T	_____	R	_____
	S	_____	T	_____	R	_____
3. Miscellaneous Property in Sec.	S	_____	T	_____	R	_____
	S	_____	T	_____	R	_____

Register of Deeds Stamp & File Number

4. Lot No. \_\_\_\_\_, Recorded Plat \_\_\_\_\_  
 5. Private Claims \_\_\_\_\_

	A	B	C	D	E	F	G	H	I	J	K	L	M
2	5		5		4		3		2		1		
3													
4	7		8		9		10		11		12		
5													
6	18		17		16		15		14		13		
7													
8	19		20		21		22		23		24		
9													
10	30		29		28		27		26		25		
11													
12	31		32		33		34		35		36		
13													

I, **RONALD L. ENGER**, in a field survey on AUGUST 23, 19 94, do hereby certify that under requirements of P.A. 74, Michigan P.A. of 1970, the corner points mentioned in lines 1 and 2 above were in conformance with regulations and rules therefore as required in the current manual of survey instructions of the United States Department of the Interior, Bureau of Land Management or by a decree of a Court of Law and/or that the corner points mentioned in lines 3, 4 and 5 above were in conformance with the rules of the Michigan Board of Land Surveyors or by a Decree of a Court of Law; established, re-established, monumented, re-monumented, recovered, found as expressed below:

NOTE: Not more than 4 corners, all in the same town and range, may be recorded on this certificate.

A. Description of original monument and accessories and/or subsequent restoration:


1. ORIGINAL POST SET BY HERVEY PARKE, DEPUTY SURVEYOR, ON DEC. 25, 1825.  
 W. OAK 20 S3E .24 (15.8')  
 DO. 6 S9E .55 (36.3')
2. T.J. BROWN, COUNTY SURVEYOR USED CORNER IN OCT. 1855 (VOL. 2, PAGE 347)  
 W.O. 23 S3E 24 (15.8')  
 DO. 11 N9E 55 (36.3')

CONTINUED ON BACK  
 B. Description of corner evidence found and/or method applied in restoring or reestablishing corner:

SEARCHED AT APPARENT LOCATION OF CORNER AND FOUND 4" CONCRETE MONUMENT IN MONUMENT BOX WITH THREE OF R. LESTER'S 1978 WITNESSES STILL STANDING. ACCEPTED CONCRETE MONUMENT AS CORNER AS PERPETUATED BY R. LESTER IN OCTOBER 1978. LEFT CONCRETE MONUMENT IN PLACE AND CAPPED IT WITH STANDARD PA 345 CAP. MEASURED WEST 2627.03' TO I-11, MEASURED EAST 2640.55' TO K-11. MEASURED NORTH 2637.75' TO J-10. DISTANCES ARE FROM TRAVERSES RUN DURING SUPER COLLIDER PROJECT.

C. Description of monument for corner and accessories established to perpetuate locating the position of the corner:

J-11 T1N R2W  
 CONCRETE MONUMENT AND PA 345 CAP PS 28409 IN MONUMENT BOX  
 NAIL AND TAG 28414 (M. MAHIEU) IN NORTH SIDE 30" MAPLE, NAZ 135°, 33.44'  
 NAIL AND TAG 18998 IN EAST SIDE 28" MAPLE, NAZ 247°, 49.00'  
 NAIL AND TAG 28414 IN EAST SIDE 10" MAPLE, NAZ 341°, 46.64'  
 NAIL AND TAG 28414 IN WEST SIDE 18" MAPLE, NAZ 32°, 44.52'  
 SOUTHEAST CORNER HOUSE FOUNDATION, NAZ 310°, 86.88'  
 CORNER IS 1.5' SOUTH OF CENTERLINE OLDS ROAD AND ON OCCUPATION LINES TO NORTH AND SOUTH

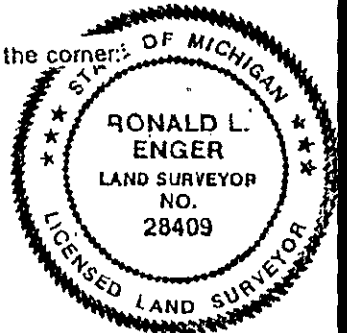

Signed by Ronald L. Enger Date NOVEMBER 4, 1994

Surveyor's Michigan License No. 28409

P.A. 345 INGHAM COUNTY  
 PEER APPROVED 11/9/94 MC

J-11 T1N R2W  
PART A CONTINUED

3. A.P. DRAKE, COUNTY SURVEYOR, USED CORNER IN NOV. 1881, (VOL. 3, PAGE 183)  
IRON POST  
HICK 4 N12W 51½ (34.0)  
W.O. 6 N31E 65½ (43.2)

4. RONNIE LESTER, LS 18998, RECORDED CORNER IN 1978 (LIBER 5 OF CORNERS, PAGE 47),  
DURING THE INGHAM COUNTY SURVEY AND REMONUMENTATION PROJECT AS A 4" CONCRETE  
MONUMENT IN CONCRETE COLLAR REPLACING A FOUND PLOW POINT, STONES, AND CROCKERY  
FOUND BY EXCAVATION.  
NAIL AND TAG #12034 W. SIDE 18" MAPLE, NE, 44.58'  
NAIL AND TAG #12034 E. SIDE 24" MAPLE, SE, 33.79'  
NAIL AND TAG #12034 W. SIDE PP, NNE, 33.17'  
NAIL AND TAG #18998 SW SIDE 32" MAPLE, SW, 50.07'

5. B. ANTCLIFF, LS 25826, USED CORNER IN NOVEMBER 1988 (LIBER 5 OF SURVEYS, PAGES  
968-973)  
½" ROD IN CONC.  
S64W, NAIL IN 24" MAPLE, 49.00'  
N10E, NAIL IN UTIL. POLE, 33.10'  
N34E, NAIL IN 15" MAPLE, 44.50'  
S45E, NAIL IN 24" MAPLE, 33.90'

6. R. HELSEL, LS 18994 USED CORNER IN MAY 1992 (LIBER 6 OF SURVEYS, PAGE 1151) WITH  
SAME MONUMENT AND WITNESSES AS ITEM 4.