

**SURVEY & REMONUMENTATION**

**LAND CORNER RECORDATION CERTIFICATE**  
Filing Requirement of Act 74, Mich. P.A. 1970

DEC 1 10 04 AM '94

For corners in  
**INGHAM**

APR 10 1995

REGISTER OF DEEDS

INGHAM COUNTY, MICH.

(County)  
**ONONDAGA TOWNSHIP**

Located In:

Corner Code 44

1. Public Land Survey	T	<u>1N</u>	R	<u>2W</u>	<u>K-9</u>
	T	_____	R	_____	_____
	T	_____	R	_____	_____
	T	_____	R	_____	_____
2. Property Controlling in Section	S	_____	T	_____	R
	S	_____	T	_____	R
3. Miscellaneous Property in Sec.	S	_____	T	_____	R
	S	_____	T	_____	R

Register of Deeds Stamp & File Number

4. Lot No. \_\_\_\_\_, Recorded Plat \_\_\_\_\_  
5. Private Claims \_\_\_\_\_

A	B	C	D	E	F	G	H	I	J	K	L	M
2	6	5	4	3	2	1						
3												
4	7	8	9	10	11	12						
5												
6	18	17	16	15	14	13						
7												
8	19	20	21	22	23	24						
9												
10	30	29	28	27	26	25						
11												
12	31	32	33	34	35	36						
13												

I, RONALD L. ENGER, in a field survey on SEPTEMBER 2, 1994, do hereby certify that under requirements of P.A. 74, Michigan P.A. of 1970, the corner points mentioned in lines 1 and 2 above were in conformance with regulations and rules therefore as required in the current manual of survey instructions of the United States Department of the Interior, Bureau of Land Management or by a decree of a Court of Law and/or that the corner points mentioned in lines 3, 4 and 5 above were in conformance with the rules of the Michigan Board of Land Surveyors or by a Decree of a Court of Law; established, re-established, monumented, re-monumented, recovered, found as expressed below:

NOTE: Not more than 4 corners, all in the same town and range, may be recorded on this certificate.

A. Description of original monument and accessories and/or subsequent restoration:

1. ORIGINAL POST SET BY HERVEY PARKE, DEPUTY SURVEYOR, ON DEC. 26, 1825.  
W.O. 30 S14W 64 (42.2')  
B.O. N½E 101 (66.7')

2. A MARGINAL NOTE IN THE INGHAM COUNTY REGISTER OF DEEDS' COPY OF GLO NOTES "NEW B. CHERRY 6 S7½W 193 (127.4') COR SCHOOL HOUSE N41½E. 179½ (118.5)'"  
SW


CONTINUED ON BACK

B. Description of corner evidence found and/or method applied in restoring or reestablishing corner:

SEARCHED AT APPARENT LOCATION OF CORNER AND FOUND BOAT SPIKE 1' SOUTH OF CENTERLINE BELLEVUE ROAD AND 1.5' WEST OF THE CENTERLINE OF EDGAR ROAD AND PROVED IT TO BE IN THE LOCATION RECORDED BY ME BY 4 OF THE 1988 WITNESSES STILL IN EXISTENCE. WITH THE HELP OF A LOCAL RESIDENT AND FORMER STUDENT OF THE SCHOOL MENTIONED IN ITEM A2 FOUND SW CORNER OF STONE FOUNDATION OF SAID SCHOOL AND MEASURED N40°E 118'+/- FROM BOAT SPIKE TO SCHOOL CORNER. EXCAVATED TO A DEPTH OF 4 FEET AROUND BOAT SPIKE AND FOUND NOTHING MORE. ACCEPTED BOAT SPIKE AS PERPETUATION OF CORNER BECAUSE OF AGREEMENT WITH HISTORICAL WITNESSES AND SET STANDARD BAR AND PA 345 CAP AND MONUMENT BOX. MEASURED SOUTH 2628.06' TO K-10. MEASURED WEST 2638.48' TO J-9. MEASUREMENTS ARE FROM TRAVERSE PERFORMED DURING SUPER COLLIDER PROJECT OF 1988.

C. Description of monument for corner and accessories established to perpetuate locating the position of the corner:

K-9 T1N R2W  
3/4" X 24" SMOOTH STEEL BAR AND PA 345 CAP PS 28409 IN MONUMENT BOX  
NAIL & TAG 28409 IN WEST SIDE 33" LOCUST, NAZ 162°, 35.04'  
NAIL & TAG 28409 IN S.E. SIDE 22" MAPLE, NAZ 57°, 48.06'  
NAIL & TAG 28409 IN EAST SIDE 20" MAPLE, NAZ 338°, 65.90'  
S.E. CORNER FOUNDATION OF HOUSE #4030, NAZ 330°, 93.57'  
N.E. CORNER GARAGE FOUNDATION, NAZ 158°, 100.21'  
INGHAM COUNTY TEMPORARY POINT (½" BAR & CAP), NAZ 182°, 8.58'

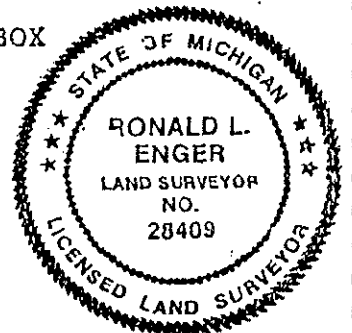

Signed by Ronald L. Enger Date NOVEMBER 1, 1994

Surveyor's Michigan License No. 28409

2760

P.A. 345 INGHAM COUNTY  
PEER APPROVED 11/09/94

K-9 TLN R2W  
PART A CONTINUED

3. A. JACKSON, CO. SURVEYOR, USED CORNER IN OCT. 1839 (VOL 1, PAGE 18)  
STUMP W.O. 18 N28E 39  
W.O. 16 N86E 40

4. A MARGINAL NOTE ON ITEM 3 BY W.H. RAYNER GIVES SAME WITNESSES AS IN ITEM 2.

5. A MARGINAL NOTE ON ITEM 3 BY W.H. RAYNER: "THIS SECTION CORNER 23, 24, 25, & 26 I LOCATED FROM THE BEST AUTHORITY AND AT THE BEST OF MY ABILITY WITHOUT PARTIALITY TO ANYONE APRIL 25, 1866."

6. T.J. BROWN, COUNTY SURVEYOR, USED CORNER IN SEPT. 1872 (VOL. 3, PAGE 63) WITH SAME MONUMENT AND WITNESSES AS ITEMS 2 AND 4.

7. INGHAM COUNTY ROAD COMMISSION -- GRID MAP  
1/2" IRON, STONE  
30" ELM, NNW 68.95'  
26" LOCUST NW 47.85'  
14" MAPLE ENE 86.27'  
T.P. SOUTH 63.85'

8. FRED WHITE LS 12034 RECORDED CORNER (LIBER 2 OF CORNERS, PAGE 201) AND USED IN A SURVEY (LIBER 1, PAGE 687 IN SEPT. 1972.  
FD. BOLT SPIKE  
15" MAPLE N60°E 47.83'  
36" LOCUST S03°E 28.35'  
15" MAPLE N78°E 82.90'

9. GLENN FAUSER, LS 18657, USED CORNER IN FEBRUARY, 1979 (LIBER 3 OF SURVEYS, PAGE 830) WITH NO MENTION OF MONUMENT OR WITNESSES.

10. A. WILLIAMS, LS 21265, USED CORNER IN MARCH, 1979, (LIBER 3 OF SURVEYS, PAGE 961) WITH SAME MON. AND WITNESSES AS ITEM 8.

11. RON ENGER, LS 28409, RECORDED CORNER IN NOVEMBER, 1988 (LIBER 7 OF CORNERS, PAGE 103) AS A BOAT SPIKE PROVED TO OCCUPY SAME LOCATION AS CORNER RECORDED BY FRED WHITE BY TWO OF WHITE'S WITNESSES STILL IN EXISTENCE.  
SE COR HOUSE FDN., #4030, 330°NAZ 93.6'  
NAIL AND TAG E. SIDE 14" MAPLE 338° NAZ 66.0'  
NAIL AND TAG W. SIDE 40" LOCUST 178° NAZ. 28.4'  
NAIL AND TAG SE SIDE 24" MAPLE 57° NAZ 48.1'  
NAIL AND TAG S. SIDE OF 15" MAPLE 75°NAZ 82.4'  
NE COR GAR. 161°NAZ 100.2'  
CORNER IS 1' SOUTH OF CENTERLINE BELLEVUE RD. AND 1.5' WEST OF CENTERLINE EDGAR RD.

12. BRUCE ANTCLIFF LS 25826 USED CORNER IN NOV. 1988 (LIBER 5 OF SURVEYS, PAGES 932-947 AND 952-967) WITH SAME MONUMENT AND WITNESSES AS ITEM 11.

13. J. GRANGER, LS 16041, USE CORNER IN A SURVEY IN JANUARY, 1994 (LIBER 7 OF SURVEYS, PAGES 79-82) WITH REFERENCE TO LIBER 7 OF CORNERS, PAGE 103.