

SURVEY &
REMONUMENTATION

LIBER 17 PAGE 343
FILED

OCT 13 1993

COMMISSION

LAND CORNER RECORDATION CERTIFICATE
Filing Requirement of Act 74, Mich. P.A. 1970

SEP 28 8 18 AM '93

For corners in

<u>INGHAM</u> (County)	Located In:	Corner Code #
<u>INGHAM TOWNSHIP</u>		
1. Public Land Survey	T <u>2N</u> R <u>1E</u>	<u>C-7</u>
	T _____ R _____	_____
	T _____ R _____	_____
	T _____ R _____	_____
2. Property Controlling in Section	S _____ T _____ R _____	_____
	S _____ T _____ R _____	_____
3. Miscellaneous Property in Sec.	S _____ T _____ R _____	_____
	S _____ T _____ R _____	_____
4. Lot No. _____, Recorded Plat _____		
5. Private Claims _____		

REGISTER OF DEEDS
Paul Johnson
INGHAM COUNTY, MICH.

Register of Deeds Stamp & File Number

A	B	C	D	E	F	G	H	I	J	K	L
2	6	5	4	3	2	1					
3											
4	7	8	9	10	11	12					
5											
6	18	17	16	15	14	13					
7		⊕									
8	19	20	21	22	23	24					
9											
10	30	29	28	27	26	25					
11											
12	31	32	33	34	35	36					
13											

I, DAVID R. LOHR, in a field survey on MAY 20, 19 93, do hereby certify that under requirements of P.A. 74, Michigan P.A. of 1970, the corner points mentioned in lines 1 and 2 above were in conformance with regulations and rules therefore as required in the current manual of survey instructions of the United States Department of the Interior, Bureau of Land Management or by a decree of a Court of Law and/or that the corner points mentioned in lines 3, 4 and 5 above were in conformance with the rules of the Michigan Board of Land Surveyors or by a Decree of a Court of Law; established, re-established, monumented, re-monumented, recovered, found as expressed below:

NOTE: Not more than 4 corners, all in the same town and range, may be recorded on this certificate.

A. Description of original monument and accessories and/or subsequent restoration:
C-7

1. POST SET BY JOSEPH WAMPLER, DEPUTY SURVEYOR, 1826 AND WITNESSED BY WHITE OAK 30" SOUTH 38° EAST, 13 LINKS; 18" WHITE OAK, NORTH 39° EAST, 37 LINKS.
2. SAME POST AND WITNESSES USED BY A. JACKSON, COUNTY SURVEYOR, 1841, RECORDED IN VOLUME 1, PAGE 139, INGHAM COUNTY SURVEYOR'S RECORDS.
3. NO OTHER REFERENCES FOUND.

- OVER -

B. Description of corner evidence found and/or method applied in restoring or reestablishing corner:

FOUND ONLY REMAINING WITNESS FROM 1959 ROAD COMMISSION WITNESSES. FOUND BOATSPIKE IN REMAINS OF 20" STUMP. S 18° 43' E, 80.90'.

ORIGIN OF 1/2" IRON RE-BAR IS UNKNOWN, HOWEVER IT OCCUPIES LOCATION OF PREVIOUSLY WITNESSED BOATSPIKE.

FOUND 1/2" IRON IN MONUMENT BOX IN THE CENTERLINE OF M-36 AND MERIDIAN ROAD, AND IS ACCEPTED AS THE BEST AVAILABLE EVIDENCE OF THE POSITION OF THE ORIGINAL CORNER IN POSITION OF BOATSPIKE. FOUND BOATSPIKE WITNESS FROM 1959, ROAD COMMISSION, AT SOUTH, 18°43' EAST, 80.90. 1/2" IRON OCCUPIES SAME POSITION AS BOATSPIKE REFERRED TO IN 1959.

C. Description of monument for corner and accessories established to perpetuate locating the position of the corner:

C-7
LEFT 1/2" IRON IN MONUMENT BOX, AND ACCEPTED IRON AS BEST AVAILABLE EVIDENCE OF THE POSITION OF THE ORIGINAL CORNER.

- FOUND PK AND SET NAIL AND TAG #30090 WEST SIDE OF 14" ASH Az. 156°29', 64.05'
- FOUND PK AND SET NAIL AND TAG #30090 SOUTHEAST SIDE OF POWER POLE Az. 217°57', 124.37'
- SET NAIL AND TAG #30090 SOUTHWEST SIDE OF POWER POLE Az. 326°42', 126.90'
- SET NAIL AND TAG #30090 NORTHEAST SIDE OF 21" ASH Az. 111°24', 141.20'
- FOUND BOATSPIKE WEST SIDE OF 20" STUMP Az. 161° 80.90'


Signed by David R. Lohr
Surveyor's Michigan License No. 30090

Date AUG. 24, 1993

filed 10/13/93
2485

P.A. 345 INGHAM COUNTY
PEER APPROVED 9/1/93

FORM APPROVED BY MICHIGAN STATE BOARD OF LAND SURVEYORS 14, 1977
REVISED JAN. 1988

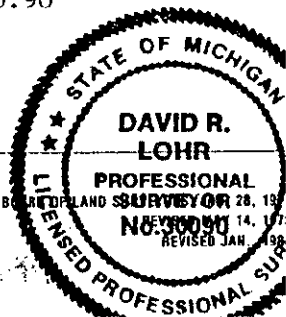

PART A CONTINUED

C-7

4. NO REFERENCES MADE ON MERIDIAN ROAD PLANS OF 1922.

5. INGHAM COUNTY ROAD COMMISSION, MERIDIAN ROAD FIELD NOTES DATED AUGUST 18, 1959, "FOUND BOATSPIKE AT CENTERLINE OF M-36 AT STA. 52+96.75. WITNESSED BY SPIKE IN T.P., ENE, 62.90' SPIKE IN 30" MAPLE, SSE, 80.70'; SPIKE IN T.P., NORTHWEST 59.90'. FOUND BOATSPIKE SOUTH 18°43' EAST, 80.90'."

6. CORNER RECORDED BY GARY LESTER IN LIBER 1, PAGE 173. DATE SEPTEMBER 21, 1971. "FOUND BOATSPIKE AT INTERSECTION OF M-36 AND MERIDIAN ROAD. DISTANCES SOUTH AND EAST IN CLOSE ACCORD WITH ORIGINAL GOVERNMENTAL MEASURE." WITNESSED BY:

NAIL AND TAG IN SOUTHWEST SIDE OF POWER POLE, NORTHWEST, 60.32'
NAIL AND TAG IN NORTHWEST SIDE OF POWER POLE, NORTHEAST, 63.23'
NAIL AND TAG IN NORTH SIDE OF 48" MAPLE, WSW, 113.57'

"FOUND BOATSPIKE AT INTERSECTION OF M-36 AND MERIDIAN ROAD"

7. INGHAM COUNTY REMON SQUAD, APRIL 17, 1978, "FOUND BOATSPIKE AS PER LIBER 1, PAGE 173 AND ACCEPTED IT AS SECTION CORNER."

8. CORNER REFERENCED IN SURVEY BY A. WILLIAMS, LS #21275, ON APRIL 4, 1978 AS RECORDED IN LIBER 3, PAGE 298. NO MENTION OF MONUMENT OR WITNESSES.

9. CORNER REFERENCED IN SURVEY BY MAURICE H. MAHIEU, LS #28414, ON DECEMBER 6, 1991 AS RECORDED IN LIBER 6, PAGE 921. "FOUND 1/2" IRON ROD IN MONUMENT BOX"
WITNESSED BY:

NAIL AND TAG WEST SIDE OF 18" ASH, SOUTH 25° EAST, 64.05'
EAST EDGE OF EAST SIGN POST, NORTH 15° WEST, 58.72'
NORTH EDGE OF REFLECTOR POST, SOUTH 45° EAST, 64.00'
NORTH EDGE REFLECTOR POST, SOUTH 60° WEST, 57.05'

10. PRIVATE SURVEYORS RECORDS REVEAL NO ADDITIONAL DATA.