

**SURVEY &
REMONUMENTATION**

OCT 21 1993

COMMISSION

For corners in

LAND CORNER RECORDATION CERTIFICATE
Filing Requirement of Act 74, Mich. P.A. 1970

LIBER

7 PAGE 353

FILED

<u>INGHAM</u> (County)	Located In:	Corner Code #
INGHAM TOWNSHIP		
1. Public Land Survey	T <u>2N</u> R <u>1E</u>	<u>E-8</u>
	T _____ R _____	_____
	T _____ R _____	_____
	T _____ R _____	_____
2. Property Controlling in Section	S _____ T _____ R _____	_____
	S _____ T _____ R _____	_____
3. Miscellaneous Property in Sec.	S _____ T _____ R _____	_____
	S _____ T _____ R _____	_____

OCT 5 8 38 AM '93

REGISTERED
INGHAM COUNTY, MICH.

Register of Deeds Stamp & File Number

4. Lot No. _____, Recorded Plat _____
5. Private Claims _____

A	B	C	D	E	F	G	H	I	J	K	L
2	6	5	4	3	2	1					
3											
4	7	8	9	10	11	12					
5											
6	18	17	16	15	14	13					
7											
8	19	20	21	22	23	24					
9											
10	30	29	28	27	26	25					
11											
12	31	32	33	34	35	36					

I, DAVID R. LOHR, in a field survey on JUNE 1, 19 93, do hereby certify that under requirements of P.A. 74, Michigan P.A. of 1970, the corner points mentioned in lines 1 and 2 above were in conformance with regulations and rules therefore as required in the current manual of survey instructions of the United States Department of the Interior, Bureau of Land Management or by a decree of a Court of Law and/or that the corner points mentioned in lines 3, 4 and 5 above were in conformance with the rules of the Michigan Board of Land Surveyors or by a Decree of a Court of Law; established, re-established, monumented, re-monumented, recovered, found as expressed below:

NOTE: Not more than 4 corners, all in the same town and range, may be recorded on this certificate.

A. Description of original monument and accessories and/or subsequent restoration:

E-8

1. POST SET BY JOSEPH WAMPLER, DEPUTY SURVEYOR, 1826 WITNESSED BY BEECH 8" S47° WEST, 18 LINK BEECH 6" N10° EAST, 13 LINKS.
2. SAME POST AND WITNESSES BY A. JACKSON, 1853, VOL 2 PAGE 165.
3. SAME POST AND WITNESSES USED BY DAVID HOLMES, DEPUTY SURVEYOR, 1855, RECORDED IN VOLUME 1, PAGE 321, INGHAM COUNTY SURVEYORS RECORDS.

CONTINUED ON BACK

B. Description of corner evidence found and/or method applied in restoring or reestablishing corner:

E-8 FOUND 1/2" REBAR AND CAP #17640 AT INTERSECTION OF FOUR FENCES AS PER P.A.-74, LIBER 7 PAGE 284.

EXCAVATED AREA AROUND 1/2" REBAR AND FOUND REMAINS OF 6" CEDAR POST 6" DEEP AND 0.30' EAST X 0.30' SOUTH OF REBAR. BELIEVED TO BE REMAINS OF ORIGINAL POST.

THIS CORNER IS ACCEPTED AS A CAREFUL AND FAITHFUL PERPETUATION OF THE POSITION OF THE ORIGINAL CORNER.

INVESTIGATION AND RESEARCH CONDUCTED VIA INGHAM COUNTY REMONUMENTATION PROJECT, 1993.

C. Description of monument for corner and accessories established to perpetuate locating the position of the corner:


E-8 LEFT 1/2" REBAR AND CAP #17640 IN PLACE WITH THE FOLLOWING WITNESSES:

- | | |
|--|------------------|
| SET NAIL AND TAG #30090 W/S 15" BEECH | Az. 19°, 38.79' |
| FOUND NAIL AND TAG #17640 NW/S 8" BEECH | Az. 62°, 15.41' |
| SET NAIL AND TAG #30090 S/S 15" RED OAK | Az. 264°, 39.20' |
| FOUND NAIL AND TAG #17640 NE/S 8" BEECH | Az. 320°, 17.46' |
| FOUND NAIL AND TAG #18998 W/S 6" RED OAK | Az. 341°, 26.65' |

Signed by David R. Lohr

Date SEPT. 8, 1993

Surveyor's Michigan License No. 30090

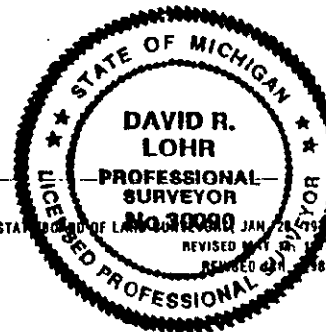

FORM APPROVED BY MICHIGAN STATE BOARD OF LAND SURVEYORS JAN 28 1993

10/21/93
pm

2490

P.A. 345 INGHAM COUNTY
PEER APPROVED 9/14/93

PART A CONTINUED

E-8

4. SURVEY BY W.H. RAYNER, COUNTY SURVEYOR, JANUARY 1866, FOLDER 1, PAGE 45, WITNESSED BY BEECH 7" $N35-3/4^{\circ}$ EAST, 31 LINKS, IRONWOOD 8" $N61\frac{3}{4}^{\circ}$ WEST, 17 LINKS. DISTANCE NOTED TO NORTH AT 79 CHAINS 22 LINKS.

5. 1/2" BAR AND CAP SET AT BASE OF FOUR-WAY FENCE INTERSECTION BY GEORGE YOUNG, PS #17640 IN UNRECORDED SURVEY ("WILLIAMS/KOVACH") ON MARCH 16, 1987. WITNESSED BY:

NAIL AND TAG IN 6" BEECH NW 17.50'
 NAIL AND TAG IN 6" BEECH NE 15.45'
 NAIL AND TAG IN 18" BEECH N 39.00'

6. CORNER FOUND BY RONNIE LESTER, LS#18998, RECORDED IN LIBER 7 PAGE 284 ON JUNE 29, 1992 TO BE "BAR AND CAP # 17640 (GEORGE YOUNG) AND STEEL POST AT BASE OF OLD FENCE CORNER POST MEASURED NORTH 2630.20', MEASURED EAST 2627.70'. ACCEPTED AS PERPETUATED LOCATION OF WEST CORNER SECTION 21,"

WITNESSED BY:

NAIL AND CAP #17640 NE SIDE 8" BEECH, 320° Az. 17.50'
 NAIL AND CAP #17649 NW SIDE 8" BEECH, 62° Az. 15.30'
 NAIL AND CAP #17640 WEST SIDE 12" BEECH, 38.8'
 SET NAIL AND TAG IN WEST SIDE 6" RED OAK, 340° Az. 26.60'

7. CORNER REFERENCED IN SURVEY BY MAURICE H. MAHIEU, LS #28414, ON OCTOBER 7, 1992, RECORDED IN LIBER 6, PAGE 1063. FOUND TO BE "1/2" IRON ROD WITH CAP #17640". WITNESSED BY:

NAIL AND TAG #28414 SOUTH SIDE 36" BEECH, EAST 21.45'
 NAIL AND TAG #17640 EAST SIDE 12" BEECH, NORTH 45°, WEST 17.15'
 NAIL AND TAG #28414 EAST SIDE 10" CHERRY, NORTH 23.65'
 NAIL AND TAG #17640 WEST SIDE 24" BEECH, NORTH 15° EAST 38.80'