

NOV 04 1993

COMMISSION LAND CORNER RECORDATION CERTIFICATE Filing Requirement of Act 74, Mich. P.A. 1970

OCT 18 11 11 AM '93

REGISTER OF DEEDS Paul Johnson INGHAM COUNTY, MICH.

For corners in

INGHAM (County) Located In: Corner Code # 1. INGHAM TOWNSHIP Public Land Survey T 2N R 1E G-7 2. Property Controlling in Section S T R 3. Miscellaneous Property in Sec. S T R 4. Lot No. Recorded Plat 5. Private Claims

Register of Deeds Stamp & File Number

Grid table with columns A-M and rows 2-13. A circled 'X' is located at the intersection of column G and row 7.

I, DAVID R. LOHR, in a field survey on MAY 20, 19 93, do hereby certify that under requirements of P.A. 74, Michigan P.A. of 1970, the corner points mentioned in lines 1 and 2 above were in conformance with regulations and rules therefore as required in the current manual of survey instructions of the United States Department of the Interior, Bureau of Land Management or by a decree of a Court of Law and/or that the corner points mentioned in lines 3, 4 and 5 above were in conformance with the rules of the Michigan Board of Land Surveyors or by a Decree of a Court of Law; established, re-established, monumented, re-monumented, recovered, found as expressed below:

NOTE: Not more than 4 corners, all in the same town and range, may be recorded on this certificate.

A. Description of original monument and accessories and/or subsequent restoration:

- G-7 1. POST SET BY JOSEPH WAMPLER, DEPUTY SURVEYOR, 1826, WITNESSED BY WHITE OAK NORTH 1° WEST, 16 LINKS, SUGAR MAPLE SOUTH 82° WEST, 15 LINKS. 2. NO OTHER REFERENCES FOUND IN COUNTY SURVEYORS RECORDS.

CONTINUED ON BACK

B. Description of corner evidence found and/or method applied in restoring or reestablishing corner:

- G-7 FOUND IRON STRAP AS PER ROAD COMMISSION MAP, NO BRICK FOUND, 16" DEEP AT CENTERLINE OF CLARK ROAD AND CENTERLINE OF M-36. NO MONUMENT BOX. DID NOT FIND "T" BAR ON EAST SIDE OF HOLE AS PER ITEM #4 AND #5 (SECTION A). ONE REMAINING WITNESS (Az. 243°26', 69.50') IN 28" TREE CONFIRMS LOCATION OF IRON STRAP AS THAT OF 1971 (ITEM #4, SECTION A). IRON STRAP ALSO CONFORMS WITH NOTATION ON UNDATED ROAD COMMISSION WITNESS MAP (ITEM #3, SECTION A) IRON STRAP APPEARS TO OCCUPY SAME POSITION AS MISSING T-BAR. WITNESSES MATCH TO 24" OAK, WSW, 69.50'. IRON STRAP ACCEPTED AS CORNER.

THIS CORNER IS ACCEPTED AS THE BEST AVAILABLE EVIDENCE OF THE POSITION OF THE ORIGINAL CORNER.

C. Description of monument for corner and accessories established to perpetuate locating the position of the corner:

- G-7 LEFT IRON STRAP 16" DEEP AT CENTERLINE OF CLARK ROAD AND CENTERLINE OF M-36, AND SET 3/4" X 24" REMON PIN WITH CAP OVER IRON STRAP. SET MONUMENT BOX OVER 3/4" IRON PIN. WITNESSED BY: FOUND NAIL AND TAG #28414 WEST SIDE OF POWER POLE Az. 19°38', 146.10' FOUND NAIL AND TAG #28414 WEST SIDE OF 8" TREE Az. 313°21', 83.45' FOUND NAIL AND TAG #18998 NW SIDE OF POWER POLE Az. 147°58', 68.68' SET NAIL AND TAG #30090 NW SIDE OF 28" ELM Az. 243°26', 69.50' SET NAIL AND TAG #30090 SE SIDE OF 12" TREE SW Az. 219°35', 147.10'


Signed by David R. Lohr

Date AUGUST 24, 1993

Surveyor's Michigan License No. 30090

FORM APPROVED BY MICHIGAN STATE BOARD OF SURVEYORS AND MAPPING REVISED MAY 14, 1982

P.A. 345 INGHAM COUNTY PEER APPROVED 10/14/93

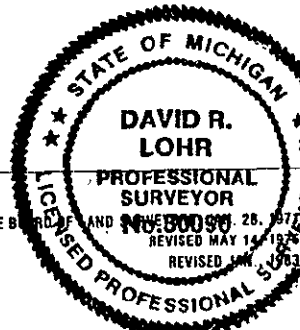

2506 11-5-93

PART A CONTINUED

G-7 3. INGHAM COUNTY ROAD COMMISSION TOWNSHIP WITNESS MAP (NO DATE) SHOWS "IRON, BRICK," WITNESS BY:

16" ELM, WSW 55.5'
14" APPLE, SE 127.50'

4. CORNER RECORDED BY GARY LESTER IN LIBER 1, PAGE 163 ON AUGUST 24, 1971. "FOUND T-BAR AT INTERSECTION OF CLARK ROAD AND M-36. MEASUREMENT WEST IN CLOSE ACCORD WITH ORIGINAL GOVERNMENTAL MEASURE." WITNESSED BY:

NAIL AND TAG IN SW SIDE OF 24" OAK, WSW, 69.51'
NAIL AND TAG IN EAST SIDE OF POWER POLE, NW, 50.06'
NAIL AND TAG IN SE SIDE OF POWER POLE, ENE, 136.25'

5. INGHAM COUNTY REMON SQUAD ON APRIL 12, 1978 "FOUND T-BAR ON EAST SIDE OF 8" HOLE." WITNESSED BY:

FOUND NAIL AND TAG NW SIDE OF 28" TREE, SOUTH 50° WEST, 69.51' -(FELL OUT/RUSTED OFF)
FOUND NAIL AND TAG EAST SIDE OF TELEPHONE POLE, NORTH 38° WEST, 50.20' -(GONE)
FOUND NAIL AND TAG ? SIDE OF TELEPHONE POLE, NORTH 75° EAST, 136.25' -(GONE)

6. CORNER REFERRED TO BY MAYNARD DYER, RLS #21565, ON JUNE 26, 1979, ON RECORDED SURVEY, RECORDED IN LIBER 3, PAGE 921, "FOUND 1" SQUARE IRON." WITNESSED BY:

NAIL IN TELEPHONE POLE, NE, 42.21'
NAIL IN TELEPHONE POLE, NW, 49.43'
NAIL IN POWER POLE, SE, 34.91'

RESEARCH HAS UNCOVERED WHAT APPEARS TO BE AN ERROR ON SURVEY RECORDED IN LIBER 3, PG.921. IT APPEARS THAT THE WITNESSES AS SHOWN FOR G-7 AND H-7 WERE TRANSPOSED WHEN TYPED ON THE SURVEY. WITNESSES AS SHOWN FOR H-7 APPEAR TO BE THE WITNESSES FOR G-7 AND MATCH THOSE AS IN ITEM #4 ABOVE.

7. CORNER REFERENCED TO BY MAURICE MAHIEU, P.S. #28414, IN RECORDED SURVEY DATED APRIL 26, 1991 AND RECORDED IN LIBER 6 OF SURVEYS, PAGE 747. "FOUND 1" SQUARE BAR" WITNESSED BY:

N&T 17624	NW/S	42" ASH,	S70°W,	69.50'
N&T 18998	SW/S	UTIL POLE	S30°E,	89.60'
N&T 28414	SW/S	8" ELM,	N45°W,	83.45'
N&T 28414	W/S	UTIL. POLE,	N10°E,	146.10'

ADDENDUM: ITEM 8; CORNER RERERENCED IN RECORDED SURVEY BY GARY LESTER, P.S. #17624, DATED 8/25/71 AND RECORDED IN LIBER 1 OF SURVEYS, PAGE 66. "FOUND T-BAR" SAME WITNESSES AS IN ITEM #4 ABOVE.