

DEC 1 1997

LAND CORNER RECORDATION CERTIFICATE  
Filing Requirement of Act 74, Mich. P.A. 1970

Liber 9 Page 192

COMMISSION

For corners in

INGHAM Located In: Corner Code #  
(County)

INGHAM TOWNSHIP  
1. Public Land Survey T 2N R 1E K-12  
T R  
T R  
T R  
T R

2. Property Controlling S T R  
in Section S T R  
3. Miscellaneous S T R  
Property in Sec. S T R

**FILED**  
RECORDED  
970029261  
08/06/1997 08:59:58  
REGISTER OF DEEDS  
Paula Johnson  
INGHAM COUNTY, MI

Register of Deeds Stamp & File Number

4. Lot No. \_\_\_\_\_, Recorded Plat \_\_\_\_\_  
5. Private Claims \_\_\_\_\_

I, DAVID R. LOHR, in a field survey on 3/25, 1997 do hereby state that under requirements of P.A. 74, Michigan P.A. of 1970, the corner points mentioned in lines 1 and 2 above were in conformance with regulations and rules therefore as required in the current manual of survey instructions of the United States Department of the Interior, Bureau of Land Management or by a decree of a Court of Law and/or that the corner points mentioned in lines 3, 4 and 5 above were in conformance with the rules of the Michigan Board of Land Surveyors or by a Decree of a Court of Law; established, re-established, monumented, recovered, found as expressed below:

NOTE: Not more than 2 corners, all in the same town and range, may be recorded on this certificate.

A	B	C	D	E	F	G	H	I	J	K	L
1											
2	6		5		4		3		2		1
3											
4	7		8		9		10		11		12
5											
6	18		17		16		15		14		13
7											
8	19		20		21		22		23		24
9											
10	30		29		28		27		26		25
11											
12	31		32		33		34		35		36
13											

A. Description of original monument and accessories and/or subsequent restoration:

K-12: 1. "QUARTER POST" SET BY JOSEPH WAMPLER IN FEB. 1826.  
WITNESSED BY: RO (RED OAK) 16 S 50 E 4 1/2L ( 2.97' )  
WO (WHITE OAK) 11 N 5 1/4 W 26L (17.16' )  
DISTANCE NORTH & SOUTH EQUALS 40 CH. (2640')


CONTINUED ON BACK

B. Description of corner evidence found and/or method applied in restoring or reestablishing corner:

K-12: SEARCHED AT APPARENT LOCATION OF CORNER AND FOUND 3/4" REBAR, WITH WITNESSES, IN STONE PILE ON FENCE LINE EAST AS PER ITEM A-10. FENCES SOUTH, WEST AND NORTH ARE DOWN AND BARELY VISIBLE. REVIEW OF TRAVERSE NOTES FOR ITEM A-8, SHOWS DISTANCE TO NORTH OF 2640.81 FT., DISTANCE EAST OF 2668.65 FT. AND DISTANCE SOUTH OF 2624.91 FT. ACCEPTED 3/4" REBAR AS CORNER, LEFT IT IN PLACE AND SET PA #345 CAP #30090 OVER IT.

C. Description of monument for corner and accessories established to perpetuate locating the position of the corner:

K-12: 3/4" REBAR WITH PA #345 CAP #30090, IN STONE PILE ON FENCE TO EAST.  
WITNESSED BY:  
SET N&T #30090, W/S 18" OAK, N 13 E, 25.50'  
SET N&T #30090, NE/S 30" OAK, S 30 E, 18.65'  
FD. N&T #25832, E/S 30" OAK, S 10 W, 22.84'  
FD. NAIL, N/S TWIN 20" MAPLE, WEST, 11.31'  
SET N&T #30090, S/S 12" OAK, N 72 W, 27.99'  
SET N&T #30090, SW/S 12" CHERRY, N 35 W, 42.91'

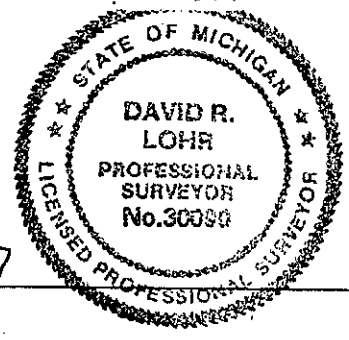

Signed by David R. Lohr  
Surveyor's Michigan License No. 30090

Date 6-16-97

K-12: INGHAM TOWNSHIP, PART A - CONTINUED

2. A. JACKSON, COUNTY SURVEYOR IN AN 1840 SURVEY RECORDED IN BOOK 4, PAGE 138. NO REFERENCE TO MONUMENT, SAME WITNESSES AS ABOVE. SURVEY SHOWS A DISTANCE EAST TO L-12 OF 160R-18 LKS. (2651.88'), AND A DISTANCE NORTH TO THE WEST 1/8 CORNER OF 79R-15 LKS, (1313.40).
3. A. JACKSON, COUNTY SURVEYOR, IN AN 1844 SURVEY RECORDED IN VOL. 1, PAGE 142 (CETA DOSSIER) COPY OF SAME SURVEY AS ITEM #2.
4. INGHAM COUNTY GRID MAP, DATED JAN. 1969, SHOWS; "1/2" IRON,"  
WITNESSESED BY: 12" TREE WEST, 11.47'  
30" OAK, S 10 W, 22.94'  
24" OAK, S 35 E, 18.60'
5. SURVEY #4589, BY OSCAR BOSS, RLS #13574, DATED 4/19/74, RECORDED IN LIBER 1, PG. 1232, STATES: "W 1/4 CORNER, SECTION 36, 1/2" IRON SET".  
WITNESSESED BY: WEST, 11.47' NAIL SET N/S DBL. TRUNKED TREE 12"  
S 10 W, 22.94' NAIL SET E/S 30" OAK  
S 35 E, 18.6' NAIL SET N/E/S 24" OAK  
SURVEY SHOWS DISTANCE SOUTH TO K-13 OF 2625.04'.  
(CALCULATED DISTANCE EAST TO HIS L-12 OF 2621.16', WHICH IS 47.37' WEST OF BRYAN'S CENTER OF SECTION. THIS WOULD TOTAL 2668.53')
6. LCRC BY OSCAR BOSS, RLS #13574, DATED 10/07/74, RECORDED IN LIBER 3, PG. 247 STATES: PART A- "K-12. UNKNOWN" PART B- "1/2" IRON SET (FENCE INTERSECTION)" "W 1/4 COR, SEC 36." SAME WITNESSES AS ABOVE.
7. SURVEY #80-B-574, BY LARRY BRYAN, PS #25832, DATED 11/20/80, RECORDED IN LIBER 7, PAGE 480, STATES: "WEST 1/4 CORNER, SECTION 36, T2N, R1E, FD. 1/2" BAR W/CAP R.L.S. #13576\* AT FENCE INTERSECTION, LIBER 3, PAGE 247.  
WITNESSED BY: FD. NAIL, N/S TWIN TREE, WEST, 11.47'  
FD. N&T E/S 30" OAK, S 10 W, 22.54'  
FD. N&T NE/S 24" OAK, S 35 E, 182.64'  
SURVEY SHOWS DISTANCE EAST TO L-12 OF 2668.65'.  
\* ( RLS #13576 SHOULD READ #13574, OSCAR BOSS.)
8. SURVEY #80-B-520, BY LARRY BRYAN, PS #25832, DATED 11/20/80, RECORDED IN LIBER 7, PAGE 484, STATES: "WEST 1/4 CORNER, SECTION 36, T2N, R1E, FD. 1/2" BAR W/CAP R.L.S. #13576\* AT FENCE INTERSECTION, LIBER 3, PAGE 247.  
WITNESSED BY: FD. NAIL, N/S TWIN TREE, WEST, 11.47'  
FD. N&T E/S 30" OAK, S 10 W, 22.54'  
FD. N&T NE/S 24" OAK, S 35 E, 182.64'  
SURVEY SHOWS DISTANCE EAST TO L-12 OF 2668.65'.  
REVIEW OF TRAVERSE COMPUTATION SHEET SHOWS DISTANCE NORTH TO K-11 OF 2640.81' AND DISTANCE SOUTH TO K-13 OF 2624.91'.  
\* ( RLS #13576 SHOULD READ #13574, OSCAR BOSS.)
9. SURVEY #84111, BY HATHAWAY J. HANES, RLS #5260, DATED 10/30/84, RECORDED IN LIBER 4, PG. 962, STATES: "WEST 1/4 POST, SEC. 36, T2N, R1E," NO MENTION OF MONUMENT OR WITNESSES. SURVEY SHOWS DISTANCE NORTH TO K-11 OF 2636.94', AND A DISTANCE EAST TO L-12 OF 2669.49'.
10. SURVEY #89-B-24536, BY LARRY BRYAN, PS #25832, DATED 04/24/89, RECORDED IN LIBER 5, PAGE 1275, STATES: "EAST 1/4 CORNER, SECTION 35, T2N, R1E, LIBER 3, PAGE 247. FOUND 3/4" REBAR AT FENCE INTERSECTION,  
WITNESSED BY: FD. NAIL, N/S 20" TWIN MAPLE, WEST, 11.4'  
SET N&T #25832 IN E/S 30" OAK, S 10 W, 22.54'  
FD. NAIL IN NE/S 30" OAK, S 30 E, 18.68'
11. NO OTHER REFERENCES FOUND.

INGHAM COUNTY MI  
 67019 700000  
 METRIEK DE DEEDS  
 08-08-1989 08:26:20  
 2100525EJ  
 3-10-89  
 HMD

1989

8 5935

1 23