

LAND CORNER RECORDATION CERTIFICATE

FILING REQUIREMENT OF ACT 74, MICH. P.A. 1970

LIBER 4 18 47

FOR CORNERS OF--	LOCATED IN--	CORNER CODE NUMBER
1. PUBLIC LAND SURVEY	T 2 N R 1 E	A-13, C-12, D-12, D-13
2. PROPERTY CONTROLLING IN SECTION	N. S. R. W.	
3. MISCELLANEOUS PROPERTY IN SECTION	N. S. R. W.	
4. LOT NO. _____	RECORDED PLAT _____	
5. PRIVATE CLAIMS _____		

FILED


APR 29 3 29 PM '77
 REGISTER OF DEEDS
 LANSING, MICHIGAN
 LANSING COUNTY, MICH.

REGISTER OF DEEDS STAMP AND FILING NUMBER

I, GEORGE M. YOUNG do hereby certify that under requirements of P.A. 1, Michigan P.A. 1970, the corner points mentioned in lines 1 and 2 above identified with circles or index code identification in a field survey on NOVEMBER 22, 1976, established, re-established, augmented, re-monumented, recovered or restored as expressed below and in conformance with regulations and rules therefore as required in the content of survey instructions of the United States Department of the Interior, Bureau of Land Management or by a decree of a court of law. Furthermore, that the corner points mentioned in lines 3 and 4 above were in a field survey on NOVEMBER 22, 1976, found, recovered, restored, established or re-established in accordance with the rules of the Michigan State Board of Registration for Land Surveyors and by a decree of a Court of Law:

A. Description of original monument and accessories and/or subsequent restoration

- A-13 ORIGINAL CORNER & ACCESSORIES UNKNOWN
- C-12 ORIGINAL CORNER & ACCESSORIES UNKNOWN
- C-13 ORIGINAL CORNER & ACCESSORIES UNKNOWN
- D-12 ORIGINAL CORNER & ACCESSORIES UNKNOWN
- D-13 ORIGINAL CORNER & ACCESSORIES UNKNOWN

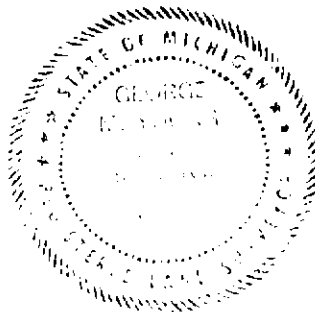

B. Description of corner evidence found and/or methods applied in restoring or re-establishing corners

- A-13 FOUND 1" x 1" STEEL ROD 2.0' UNDER ROAD SURFACE
- C-12 SET 1/4" STEEL ROD ON LINE MIDWAY BETWEEN SW & NW CORNERS OF SECTION
- C-13 SET 1/4" STEEL ROD PROPORTIONAL DISTANCE BETWEEN S 1/4 POST SECTION AND SW CORN SECTION
- D-12 FOUND FENCE POST (STEEL) SET IN ROTTED ANCHOR POST ACCEPTED AS PERPETUATION OF SECTION CORNER
- D-13 DUG 10' x 6' x 10" AREA FOUND NOTHING ACCEPTED FENCE INTERSECTIONS AS PERPETUATION OF S 1/4 POST SET 1/2" STEEL ROD
- "A" IRON ON NORTH SECTION LINE 622.18' WEST OF NORTH 1/4 POST (SEE ENCL)
- "B" IRON 1300' NORTH OF EAST-WEST VALINE IN S POTTER ROAD (SEE ENCL)
- "C" IRON ON EAST-WEST 1/4 LINE 430.81' WEST OF CENTER IN S POTTER ROAD (SEE ENCL)

C. Description of monument for corner and accessories established by perpetuation

- A-13 NAIL CAP IN 10" OAK N30°W 48.28'
- NAIL CAP IN 20" OAK N30°E 64.61'
- NAIL CAP IN 18" OAK N77°E 35.27'
- C-12 NAIL IN 6" OAK N30°W 65.00'
- NAIL IN 6" WILD CHERRY WEST 49.08'
- NAIL IN POWER POLE N88°E 44.70'
- C-13 NAIL IN TELEPHONE POLE N70°W 87.57'
- NAIL IN 12" MAPLE N85°W 44.25'
- NAIL IN 36" MAPLE S10°W 26.81'
- D-12 NAIL IN 24" OAK S85°W 16.80'
- NAIL IN 24" OAK S20°W 30.60'
- NAIL IN 20" WILD CHERRY EAST 29.08'
- D-13 NAIL IN 18" MAPLE N70°W 23.21'
- NAIL IN 18" TAMARACK S70°W 27.30'
- "A" NAIL IN 48" OAK WEST 10.10'
- "B" NAIL IN 48" WILLOW N50°E 11.64'
- "C" NAIL IN POWER POLE S45°E 20.53'
- "D" NAIL IN 6" MAPLE N75°W 10.10'
- "E" NAIL IN 36" OAK N15°E 23.82'
- "F" NAIL IN 36" MAPLE S10°W 27.30'
- "G" NAIL IN 36" OAK WEST 16.54'
- "H" NAIL IN 2" OAK S95°W 34.08'
- "I" NAIL IN 18" POPLAR S45°E 31.22'

E 1/4 cor 31

SIGNED BY: George M. Young
 SURVEYOR'S MICHIGAN REGISTRATION NO. 17640

FOR STATE AND UNITED STATES AGENCIES:

SIGNED BY: _____

APPROVED AND SIGNED BY: _____

SURVEYOR'S MICHIGAN REGISTRATION NO. _____