


Ingham Co

Form 974.

T. 2 N

R. 1 E

Mer.

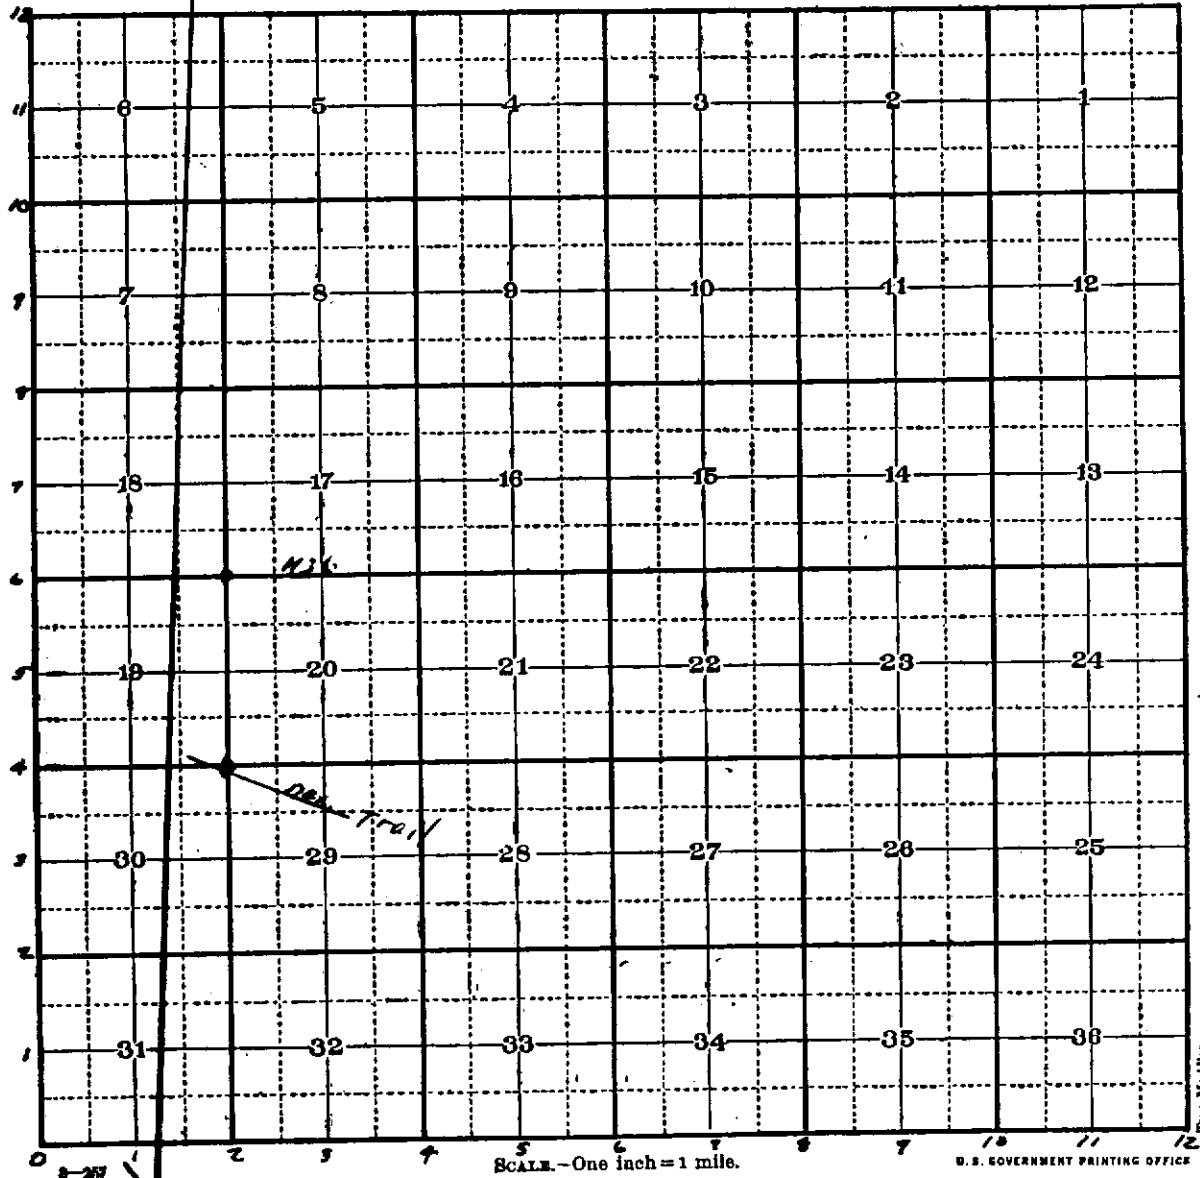

M.S. Trail

Type Meridian.