

INGHAM COUNTY - INGHAM TWP.
LAND CORNER RECORDATION CERTIFICATE
 FILING REQUIREMENT OF ACT 74, MICH. P.A.1970

6 PG 78

FOR CORNERS OF--	LOCATED IN--	CORNER CODE NUMBER
1. PUBLIC LAND SURVEY	1. 2 N. R. 1 W.	A-12
2. PROPERTY CONTROLLING IN SECTION	N. S. R. W.	
3. MISCELLANEOUS PROPERTY IN SECTION	N. S. R. W.	
4. LOT NO. _____, RECORDED PLAT _____		
5. PRIVATE CLAIMS _____		

REGISTER OF DEEDS STAMP AND FILING NUMBER

1077 A 03 100

I, Ronnie M. Lester, do hereby certify that under requirements of P.A. 74, Michigan P.A. of 1970, the corner points mentioned in lines 1 and 2 above were, in a field survey on June 12, 1980, established, re-established, monumented, re-monumented, recovered or restored as expressed below and in conformance with regulations and rules therefore as required in the current manual of survey instructions of the United States Department of the Interior, Bureau of Land Management or by a decree of a court of law. Furthermore, that the corner points mentioned in lines 3, 4 and 5 above were, in a field survey on _____, 19____, found, recovered, restored, established or re-established as expressed below and in conformance with the rules of the Michigan State Board of Registration for Land Surveyors or, by a Decree of a Court of law:


A-12
 A. Description of original monument and accessories and/or subsequent restoration:
 No post set in original government survey.
 Corner referred to in a survey by A. Jackson, County Surveyor, May 13, 1847 (v.2, p.11).
 Corner referred to in a survey by G. Edwin States, County Surveyor, November 25 & 26, 1892 (v.3, p.204).

A-12
 B. Description of corner evidence found and/or method applied in restoring or re-establishing corner:
 Excavated a 6' x 24' hole to an average depth of 1.0' on the centerline of Kelly Road and on fence line east. Found no evidence of monumentation. Corner considered lost. Set corner midway between A-13 and A-11 on standard township line or meridian. Measured north to A-11, 2621.56'; measured south to A-13, 2621.56'. Measured north to M-11, 1386.16'; measured south to M-12, 1262.59'. Corner falls in centerline of Kelly Road and \pm 5.0' north of fence line east.
 Excavation conducted by Ingham County Survey and Remonumentation Project crew.

A-12
 C. Description of monument for corner and accessories established to perpetuate locating the position of the corner:
 W $\frac{1}{2}$ Corner, Section 31, T2N-R1E
 Set 4" x 36" concrete monument with $\frac{1}{2}$ " x 38" rerod and cap #18998.
 Nail & tag, #18998, southwest side 12" Cherry, ESE, 20.06'
 Nail & tag, #18998, west side 24" Ash, SSE, 42.91'
 Nail & tag, #18998, southeast side 14" Hickory, SW, 41.58'
 Nail & tag, #18998, northeast side 12" Hickory, NNW, 49.48'

SIGNED BY: Ronnie M. Lester DATE 8/25/80

SURVEYOR'S MICHIGAN REGISTRATION NO. 18998

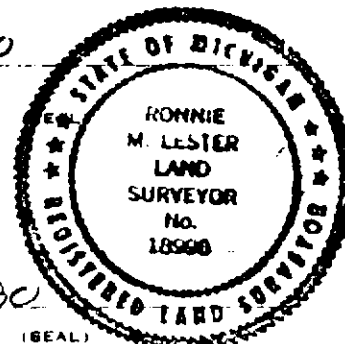

CHIEF OF SURVEY PARTY BY: Gary D. Lester DATE 8-25-80
 MICHIGAN REGISTERED LAND SURVEYOR
 Director, Ingham County Survey and Remonumentation Project

SECTION NO. 17624