

NOV 04 1993

COMMISSIONER LAND CORNER RECORDATION CERTIFICATE
Filing Requirement of Act 74, Mich. P.A. 1970

Oct 26 10 14 AM '93

For corners in

| | | |
|------------------------------------|-------------------------|---------------|
| <u>INGHAM</u> (County) | Located In: | Corner Code # |
| 1. Public Land Survey | T <u>2N</u> R <u>1W</u> | <u>E-7</u> |
| | T _____ R _____ | _____ |
| | T _____ R _____ | _____ |
| | T _____ R _____ | _____ |
| 2. Property Controlling in Section | S _____ T _____ R _____ | _____ |
| | S _____ T _____ R _____ | _____ |
| 3. Miscellaneous Property in Sec. | S _____ T _____ R _____ | _____ |
| | S _____ T _____ R _____ | _____ |

REGISTER OF DEEDS
Paul Johnson
INGHAM COUNTY, MICH.

Register of Deeds Stamp & File Number

- 4. Lot No. _____, Recorded Plat _____
- 5. Private Claims _____


| A | B | C | D | E | F | G | H | I | J | K | L |
|----|----|----|----|----|----|----|---|---|---|---|---|
| 2 | 6 | 5 | 4 | 3 | 2 | 1 | | | | | |
| 3 | | | | | | | | | | | |
| 4 | 7 | 8 | 9 | 10 | 11 | 12 | | | | | |
| 5 | | | | | | | | | | | |
| 6 | 18 | 17 | 16 | 15 | 14 | 13 | | | | | |
| 7 | | | | | | | | | | | |
| 8 | 19 | 20 | 21 | 22 | 23 | 24 | | | | | |
| 9 | | | | | | | | | | | |
| 10 | 30 | 29 | 28 | 27 | 26 | 25 | | | | | |
| 11 | | | | | | | | | | | |
| 12 | 31 | 32 | 33 | 34 | 35 | 36 | | | | | |
| 13 | | | | | | | | | | | |

I, RON HELSEL, in a field survey on SEPT. 30, 19 93, do hereby certify that under requirements of P.A. 74, Michigan P.A. of 1970, the corner points mentioned in lines 1 and 2 above were in conformance with regulations and rules therefore as required in the current manual of survey instructions of the United States Department of the Interior, Bureau of Land Management or by a decree of a Court of Law and/or that the corner points mentioned in lines 3, 4 and 5 above were in conformance with the rules of the Michigan Board of Land Surveyors or by a Decree of a Court of Law; established, re-established, monumented, re-monumented, recovered, found as expressed below:

NOTE: Not more than 4 corners, all in the same town and range, may be recorded on this certificate.

- A. Description of original monument and accessories and/or subsequent restoration:
ORIGINAL MONUMENT: POST SET BY HERVEY PARKE, U.S. DEPUTY SURVEYOR, MARCH 6, 1826.
BEARING TREES: BEECH 7, N78°W, 29 LINKS
BEECH 7, S65 1/2°E, 11 LINKS

COUNTY SURVEY RECORDS:
1). VOL. 1, PG. 38, JAN. 21, 1842 BY A. JACKSON, CO. SURVEYOR.
WITNESSES THE SAME AS ORIGINAL G.L.O.
2). VOL. 2, PG. 61, APRIL 11, 1872, BY T.J. BROWN, CO. SURVEYOR.
WITNESSED AS: "STONE BELOW THE SURFACE WITH CROCKERY AROUND IT". (CONTINUED ON BACK)
- B. Description of corner evidence found and/or method applied in restoring or reestablishing corner:
FOUND 1" PIPE IN MON. BOX 2' WEST OF E HULL RD. AND ON E TOMLINSON ROAD EAST.
FOUND (3 OF 4) WITNESSES AS RECORDED IN LIBER 6, PG. 397. EXCAVATED DOWN THROUGH BOX AND FOUND PIECES OF CROCKERY. STONE MAY HAVE BEEN REMOVED WHEN THE COUNTY SET THE MON. BOX. THREE OF R.M. LESTER'S WITNESSES WERE IN CLOSE ACCORD WITH M.F. FOUTY'S. ACCEPTED PIPE AS THE MARKER FOR THE CORNER.
- C. Description of monument for corner and accessories established to perpetuate locating the position of the corner:
1" PIPE IN MONUMENT BOX
FOUND NAIL & TAG #18989 IN N/SIDE POWER POLE, S45°E, 43.50'
FOUND NAIL & TAG (NO I.D.) IN S/SIDE UTILITY POLE, N55°E, 45.30'
NORTHWEST CORNER OF METAL POLE BARN, S27°E, 220.40'
SET GALV. NAIL & TAG #18994 W/SIDE POWER POLE, N17°E, 168.22'

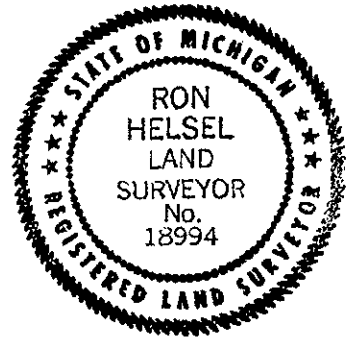

Signed by Ron Helsel Date Oct. 8, 1993
Surveyor's Michigan License No. 18994

- 3). FROM INGHAM COUNTY ROAD COMM. MAPS (CIRCA 1971)
 - 1" IRON
 - ROAD SIGN, NE, 46.30'
 - P.P., SE, 43.44'
 - N. EDGE E. FLANGE, N. POST OF GUARD RAIL, NW, 29.10'
 - 16" ELM, N34°W, 54.09'
 - 24" WALNUT, S62°E, 66.34'
 - 38" ELM, N05°W, 99.90'
 - NE COR. GAS STATION, S58°W, 73.55'
 - SW COR. HOUSE, 84.25' (NO DIRECTION)

 - 4). A C.R.C. WAS RECORDED IN LIBER 2, PG. 605, FIELD DATED AUG. 1, 1973 IN CONJUNCTION WITH A SURVEY DATED THE SAME & RECORDED IN LIBER 1, PGS. 912 & 913 BY M.F. FOUTY #18989, WITNESSED AS: BOAT SPIKE OVER STONE AT INT. OF TOMLINSON & HULL RDS.
 - NAIL & TAG IN UTILITY POLE, NE, 45.03'
 - NAIL & TAG IN UTILITY POLE, SE, 43.30'
 - CENTER OF RW FENCE POST, WEST, 34.30'

 - 5). A SURVEY RECORDED IN LIBER 2, PG. 251, & DATED SEPT. 5, 1974 BY J.E. STEPHENS #16053 REFERENCE TO COR. IN L. 2, PG. 605 WITH NO WITNESSES.

 - 6). RECORDED PUBLIC ACT 132 SURVEYS THAT ALL CALL FOR THE WITNESSES IN C.R.C. L. 2, PG. 605:
 - LIBER 3, PG. 950, JULY, 1977 BY A.C. WILLIAMS # 21275; L. 3, PG. 502, JULY, 1978 BY R. HELSEL #18994; L. 4, PGS. 660 & 661, DEC., 1982, BY A.C. WILLIAMS; L. 4, PG. 1185, OCT. 23, 1985 BY G.M. YOUNG #17640; L. 5, PG. 4, MAY 30, 1986 BY F.N. WHITE #12034.

 - 7). A C.R.C. WAS RECORDED IN LIBER 6, PG. 397, FIELD DATED SEPT. 16, 1988, BY R.M. LESTER #18998. WITNESSED AS: 1" PIPE IN MONUMENT BOX 2' WEST OF E HULL RD. ON E TOMLINSON RD., EAST
 - FOUND NAIL & TAG #18989 IN NORTH SIDE UTILITY POLE, 135° Az, 43.5'
 - FOUND NAIL & TAG IN SOUTH SIDE UTILITY POLE, 55°Az., 45.3'
 - NORTHWEST CORNER OF METAL POLE BARN, 155 ° Az., 220.4'
 - FOUND MDSH NAIL & TAG IN WEST SIDE UTILITY POLE, 17° Az., 164.0'

 - 8). SEVERAL SURVEYS BY B. ANTCLIFF #25826, CONDUCTED FOR THE SUPER COLLIDER PORJECT WERE RECORDED IN LIBER 5, PGS. 848 THROUGH 861, DATED OCT., 1988 AND WERE REFERENCED TO CORNER E-7 & WITNESSED AS: 1" PIPE IN MON. BOX
 - N17°W, NAIL IN UTILITY POLE, 164.00'
 - S45°E, NAIL IN UTILITY POLE, 43.50'
 - N55°E, NAIL IN UTILITY POLE, 45.30'
 - S25°E, NW COR. METAL BARN, 222.40'
- DID NOT FIND FURTHER MENTION OF THIS CORNER IN PUBLIC RECORDS.