

DEC 1 1993

COMMISSION

LAND CORNER RECORDATION CERTIFICATE
Filing Requirement of Act 74, Mich. P.A. 1970

FILED

For corners in
INGHAM
(County)

Located In: Corner Code #

1. Public Land Survey	T	2N	R	1W	G-6
	T		R		
	T		R		
	T		R		
2. Property Controlling in Section	S		T	R	
	S		T	R	
3. Miscellaneous Property in Sec.	S		T	R	
	S		T	R	

Oct 15 1:02 PM '93

REGISTER OF DEEDS
Paul J. Johnson
INGHAM COUNTY, MICH.

Register of Deeds Stamp & File Number

- 4. Lot No. _____, Recorded Plat _____
- 5. Private Claims _____

A	B	C	D	E	F	G	H	I	J	K
2	6	5	4	3	2					
3										
4	7	8	9	10	11					
5										
6	18	17	16	15	14					
7										
8	19	20	21	22	23					
9										
10	30	29	28	27	26					
11										
12	31	32	33	34	35					
13										

I, RON HELSEL, in a field survey on OCT. 7, 1993

do hereby certify that under requirements of P.A. 74, Michigan P.A. of 1970, the corner points mentioned in lines 1 and 2 above were in conformance with regulations and rules therefore as required in the current manual of survey instructions of the United States Department of the Interior, Bureau of Land Management or by a decree of a Court of Law and/or that the corner points mentioned in lines 3, 4 and 5 above were in conformance with the rules of the Michigan Board of Land Surveyors or by a Decree of a Court of Law; established, re-established, monumented, re-monumented, recovered, found as expressed below:


NOTE: Not more than 4 corners, all in the same town and range, may be recorded on this certificate.

A. Description of original monument and accessories and/or subsequent restoration:
 ORIGINAL MONUMENT: POST SET BY HERVEY PARKE, U.S. DEPUTY SURVEYOR ON MARCH 4, 1826.
 BEARING TREES: ELM 16, N48°W, 44 LINKS
 ELM 6, S1/2°W, 49 1/2 LINKS

1). OF THE COUNTY SURVEYOR RECORDS ON FILE, NONE WERE REFERENCED TO THIS CORNER.
 2). A C.R.C. WAS RECORDED IN LIBER 3, PG. 618, & FIELD DATED 6-23-76 BY G.M. YOUNG #17640.
 WITNESSED AS: ANCHOR POST IN CLOSE ACCORD WITH MID-POINT BETWEEN G-5 & G-7
 NAIL & CAP IN 24" MAPLE, S45°W, 34.00'
 NAIL & CAP IN 12" WILLOW, S70°W, 34.50' (CONTINUED ON BACK)

B. Description of corner evidence found and/or method applied in restoring or reestablishing corner:
 FOUND 1/2" BAR AND ALL THE WITNESSES, AS FND BY STEPHENS IN HIS C.R.C., AT THE INTERSECTION OF THE EAST-WEST & NORTH-SOUTH FENCE LINES. AN APPARENT TRENCH LINE FOR AN UNDERGROUND UTILITY LINE OBLITERATED THE ORIGINAL ANCHOR POST, AS RECORDED IN YOUNG'S C.R.C. EXCAVATED AROUND THE 1/2" BAR ±18" DEEP & FOUND A CIRCLE OF STONES WITH REMAINS OF WOOD POST IN CENTER. ACCEPTED THE 1/2" BAR AS THE CORNER MARKER & WITNESSED, SUPPORTED BY STEPHENS FINDING OF 2 OF THE 3 WITNESSES BY YOUNG. THE BAR IS SET IN THE CIRCLE OF STONES ON THE NORTHERLY EDGE OF THE POST REMAINS.

C. Description of monument for corner and accessories established to perpetuate locating the position of the corner:
 1/2" IRON BAR
 FOUND NAIL & METAL TAG #16053, S05°W, 18.02' W/SIDE 18" MAPLE
 FOUND NAIL & METAL TAG #16053, N85°W, 31.20' N/SIDE 12" ASH
 FOUND NAIL & METAL TAG #16053, N85°E, 25.41' N/SIDE 5" ASH
 FOUND NAIL & METAL TAG #16053, N25°W, 33.74' N/SIDE 24" MAPLE

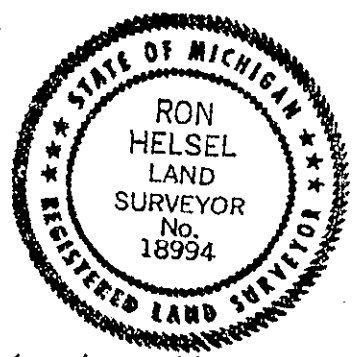

Signed by Ron Helsel Date Oct 11, 1993
Surveyor's Michigan License No. 18994

2). CONTINUED

NAIL & CAP IN TWIN 20" MAPLE, S05°W, 17.70'

3). A SURVEY RECORDED IN LIBER 2, PGS. 893-896, FIELD DATED 4-30-76 & FINAL DATED 7-26-76 BY G.M. YOUNG HAD THE SAME WITNESSES AS HIS C.R.C. IN LIBER 3, PG. 618.

4). A SURVEY RECORDED IN LIBER 5, PG. 542, DATED 8-2-88 BY G.M. YOUNG, HAD THE SAME WITNESSES AS HIS C.R.C. IN LIBER 3, PG. 618.

5). AN UNRECORDED SURVEY, DRAWING NO. 18519-EL, DATED 2/15/90 BY J.S. STEPHENS #16063 WAS DONE IN CONJUNCTION WITH HIS C.R.C. DATED 2-19-90 AND RECORDED IN LIBER 7, PG. 173. WITNESSED AS: FOUND 1/2" IRON ROD AND 2 OF 3 WITNESSES AS RECORDED IN LIBER 3, PG.618, AT THE INTERSECTION OF FENCES. THE POST HAD BEEN OBLITERATED.

WITNESSED AS: 1/2" IRON ROD
WEST SIDE TWIN 18" MAPLE TREE, SOUTH, 18.02'
NORTH SIDE 12" ASH TREE, WEST, 31.21'
NORTH SIDE 14" ASH TREE, EAST, 25.41'
NORTH SIDE 24" MAPLE TREE, NORTHWEST, 33.73'

DID NOT FIND FURTHER MENTION OF THIS CORNER IN PUBLIC RECORDS.

001E#1065 0008 MSSR \$2.00

001E#1065 0008 CORNER \$9.00

da