

OCT 21 1993

COMMISSION

LAND CORNER RECORDATION CERTIFICATE
Filing Requirement of Act 74, Mich. P.A. 1970

Oct 13 9 11 AM '93

REGISTER OF DEEDS
Paula Johnson
INGHAM COUNTY, MICH.

For corners in
INGHAM
(County)

Located In:

Corner Code #

- 1. Public Land Survey T 2N R 1W H-7
 T R _____
 T R _____
 T R _____
 T R _____
- 2. Property Controlling S _____ T _____ R _____
 in Section S _____ T _____ R _____
- 3. Miscellaneous S _____ T _____ R _____
 Property in Sec. S _____ T _____ R _____

Register of Deeds Stamp & File Number

- 4. Lot No. _____, Recorded Plat _____
- 5. Private Claims _____

I, RON HELSEL, in a field survey on OCT. 4, 19 93, do hereby certify that under requirements of P.A. 74, Michigan P.A. of 1970, the corner points mentioned in lines 1 and 2 above were in conformance with regulations and rules therefore as required in the current manual of survey instructions of the United States Department of the Interior, Bureau of Land Management or by a decree of a Court of Law and/or that the corner points mentioned in lines 3, 4 and 5 above were in conformance with the rules of the Michigan Board of Land Surveyors or by a Decree of a Court of Law; established, re-established, monumented, re-monumented, recovered, found as expressed below:

A	B	C	D	E	F	G	H	I	J	K	L
2	6	5	4	3	2	1					
3											
4	7	8	9	10	11	12					
5											
6	18	17	16	15	14	13					
7											
8	19	20	21	22	23	24					
9											
10	30	29	28	27	26	25					
11											
12	31	32	33	34	35	36					
13											

NOTE: Not more than 4 corners, all in the same town and range, may be recorded on this certificate.

A. Description of original monument and accessories and/or subsequent restoration:

ORIGINAL MONUMENT: POST SET BY HERVEY PARKE, U.S. DEPUTY SURVEYOR, ON MARCH 4, 1826.

BEARING TREES: BEECH 12, S29°W, 12 LINKS
SUGAR 8, N46 1/2°E, 19 LINKS

SURVEYS BY THE COUNTY SURVEYOR:

1). VOL. 1, PG. 51: MAR. 9, 1843 BY A. JACKSON, CO. SURVEYOR.

WITNESSES: BEECH 18, WEST, 15 LINKS
LYNN 14, N63°E, 10 LINKS


(CONTINUED ON BACK)

B. Description of corner evidence found and/or method applied in restoring or reestablishing corner:

FOUND 5/8" REBAR OVER STONE 3.5' SOUTH OF CENTERLINE TOMLINSON ROAD ON TREE LINE TO NORTH. EXCAVATION DID NOT FIND ANY OTHER EVIDENCE. REPLACED REBAR WITH 3/4" x 24" FORM PIN AND CAP LABELED P.A. 345. SET MON BOX TO GRADE AFTER ACCEPTING THE STONE & REBAR AS PERPETUATING THE CORNER.

C. Description of monument for corner and accessories established to perpetuate locating the position of the corner:

3/4" FORM PIN IN MON. BOX 3.5' SOUTH E ROAD.
SET GALV. NAIL & TAG #18994 SE/SIDE 26" OAK, N78°E, 122.71'
SET GALV. NAIL & TAG #18994 SE/SIDE TELE-POLE, S18°E, 27.11'
SET GALV. NAIL & TAG #18994 SE/SIDE 36" OAK, N13°E, 36.13'
SET GALV. NAIL & TAG #18994 NE/SIDE 32" MAPLE, S77°E, 70.34'

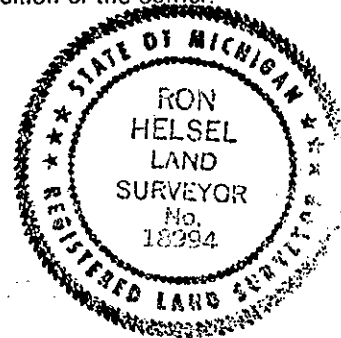

Signed by Ron Helsel Date Oct. 4, 1993
Surveyor's Michigan License No. 18994

10/21/93 gm
2494

"A" CONTINUED

- 2). VOL. 1, PG. 103; JAN. 19, 1846 BY A. JACKSON
WITNESSES: (SAME AS G.L.O.)
- 3). VOL. 2, PG. 302; NOV. 6, 1856 BY A. JACKSON
WITNESSES: (SAME AS G.L.O.)
- 4). BOOK LABELED VARIOUS SURVEYS PG. 21 1/2 & 22 1/2, SURVEYOR UNKNOWN, DATED IN 1894
WITNESSES: ELM 1/2 N4°E, 50 LINKS
CENTER TOP STONE, N44°W, 37 LINKS
- 5). FROM A COUNTY FOLDER, SET I, PG. #16, NO DATE, BY W.H. RAYNER, CO. SURVEYOR
WITNESSED: APPLE 2" S45 1/2°W, 141 LINKS
BEECH 10" N12 1/2°E, 119 2/3 LINKS

C.R.C. RECORDED IN LIBER 3, PG. 618 FIELD DATED 6/23/76 BY ^GF. M. YOUNG #17640.

HE FOUND A 5/8" RE-ROD AND WITNESSED:

NAIL IN 36" OAK, N15°E, 36.65'

NAIL IN 36" MAPLE, S80°E, 69.78'

PK NAIL IN P.P., S20°E, 27.06'

FROM REMON FIELD NOTED DATED 2-7-78, FOUND 5/8" RE-ROD WITH POWER POLE & 36" OAK WITNESSES
FROM C.R.C. L. 3, PG. 618, INTACT. SET NAIL & TAG ON NORTH SIDE OF 36" MAPLE, S80°E, 70.45'
DID NOT FIND ANY P.A. 132 SURVEYS OR ANY FURTHER MENTION OF THIS CORNER IN PUBLIC RECORDS.