

LAND CORNER RECORDATION CERTIFICATE
Filing Requirement of Act 74, Mich. P.A. 1970

For corners in

INGHAM
(County)
VEVAY TOWNSHIP

Located In:

Corner Code #

- 1. Public Land Survey T 2N R 1W K-7
2. Property Controlling in Section S T R
3. Miscellaneous Property in Sec. S T R

FILED

11/28/1995 09:36:58
REGISTER OF DEEDS
PAULA JOHNSON
INGHAM COUNTY, MI

Register of Deeds Stamp & File Number

- 4. Lot No. Recorded Plat
5. Private Claims

Grid table with columns A-M and rows 2-13. A dot is marked at the intersection of column K and row 7.

I, RONALD L. ENGER, in a field survey on OCTOBER 11, 19 95, do hereby certify that under requirements of P.A. 74, Michigan P.A. of 1970, the corner points mentioned in lines 1 and 2 above were in conformance with regulations and rules therefore as required in the current manual of survey instructions of the United States Department of the Interior, Bureau of Land Management or by a decree of a Court of Law and/or that the corner points mentioned in lines 3, 4 and 5 above were in conformance with the rules of the Michigan Board of Land Surveyors or by a Decree of a Court of Law; established, re-established, monumented, re-monumented, recovered, found as expressed below:

NOTE: Not more than 4 corners, all in the same town and range, may be recorded on this certificate.


A. Description of original monument and accessories and/or subsequent restoration:

1. POST SET IN ORIGINAL GOVERNMENT SURVEY BY HERVEY PARKE, DEPUTY SURVEYOR IN FEBRUARY 1826 AND TWO BEARING TREES RECORDED:
W.O. 10" S30W 13
ASPEN 20" N74E 69

CONTINUED ON BACK

B. Description of corner evidence found and/or method applied in restoring or reestablishing corner:

FOUND ANCHOR POST WITH 1/2" BAR IN TOP. SET STANDARD MARKER FOR PA 345 REMONUMENTATION IN INGHAM COUNTY ON NORTHWEST SIDE. ALL WITNESSES ARE TO ANCHOR POST. MEASURED SOUTH 2650.88 TO K-8.

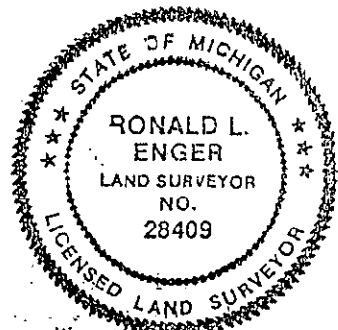

C. Description of monument for corner and accessories established to perpetuate locating the position of the corner:

K-7 T2N R1W
3/4" DIAMETER X 24" LONG SMOOTH STEEL BAR AND CAP IMPRINTED "PA 345 PS 28409".
4" SQUARE CONCRETE MONUMENT WITH 1/2" BAR IN TOP, 90° NAZ., 10.00'
4" SQUARE CONCRETE MONUMENT WITH 1/2" BAR IN TOP, 180° NAZ., 5.00'
SET 20D GALVANIZED SPIKE AND TAG PS 28409 IN NORTH SIDE OF 40" CHERRY, 90° NAZ., 3.40'
SET 20D GALVANIZED SPIKE AND TAG PS 28409 IN SOUTH SIDE OF CORNER POST FOR PHEASANT PENS, 298° NAZ., 34.85'

Signed by [Signature] 28409

OCTOBER 18, 1995

Date

Surveyor's Michigan License No.

K-7 T2N R1W
PART A CONTINUED

2. A. JACKSON, DEPUTY COUNTY SURVEYOR, USED CORNER JULY 1842, VOLUME PAGE 39. SAME MONUMENTS AND WITNESSES AS PART A #1.

3. W. L. PADISON, PS 7256 IN A SURVEY FOR THE MICHIGAN DEPARTMENT OF CONSERVATION, IN FEBRUARY 1961, CALLED OUT CORNER AS AN ANCHOR POST AND SET THE FOLLOWING WITNESSES:

- 4" SQUARE CONCRETE MONUMENT EAST 10.00'
- 4" SQUARE CONCRETE MONUMENT SOUTH 5.00'

4. R. LESTER, PS 18998, RECORDED IN LIBER 1 OF SURVEYS, PAGE 274 DATED APRIL 1972, AND IN LIBER 3 OF CORNERS, PAGE 578 DATED JUNE 1976. CORNER ESTABLISHED BY DEPARTMENT OF NATURAL RESOURCES IN 1961 WITH THE FOLLOWING WITNESSES:

- FENCE POST-SET 1/2" BAR AND CAP IN TOP.
- CONCRETE MONUMENT EAST 10.00'
- CONCRETE MONUMENT SOUTH 5.00'
- NAIL AND TAG IN SOUTHWEST SIDE OF 30" WILD CHERRY, SOUTHEAST 3.70'

DEPT. OF NATURAL RESOURCES
MICHIGAN DEPARTMENT OF CONSERVATION
DIVISION OF LANDS
LANSING, MICHIGAN 48224