

SURVEY & REMONUMENTATION

DEC 16 1996

LAND CORNER RECORDATION CERTIFICATE Filing Requirement of Act 74, Mich. P.A. 1970

Liber 9 Page 133

For corners in **INGHAM** **COMMISSION**

FILED

960046040
12/03/1996 13:23:01
REGISTER OF DEEDS
Paula Johnson
INGHAM COUNTY, MI

	Located In:	Corner Code #
(County) VEVAY TOWNSHIP		
1. Public Land Survey	T <u>2N</u> R <u>1W</u>	<u>K-9</u>
	T _____ R _____	_____
	T _____ R _____	_____
	T _____ R _____	_____
2. Property Controlling in Section	S _____ T _____ R _____	_____
	S _____ T _____ R _____	_____
3. Miscellaneous Property in Sec.	S _____ T _____ R _____	_____
	S _____ T _____ R _____	_____

Register of Deeds Stamp & File Number

4. Lot No. _____, Recorded Plat _____
5. Private Claims _____

	A	B	C	D	E	F	G	H	I	J	K	L	M
2	6	5	4	3	2	1							
3													
4	7	8	9	10	11	12							
5													
6	16	17	16	15	14	13							
7													
8	19	20	21	22	23	24							
9													
10	30	29	28	27	26	25							
11													
12	31	32	33	34	35	36							
13													

I, RONALD L. ENGER in a field survey on OCTOBER 11, 19 95, do hereby certify that under requirements of P.A. 74, Michigan P.A. of 1970, the corner points mentioned in lines 1 and 2 above were in conformance with regulations and rules therefore as required in the current manual of survey instructions of the United States Department of the Interior, Bureau of Land Management or by a decree of a Court of Law and/or that the corner points mentioned in lines 3, 4 and 5 above were in conformance with the rules of the Michigan Board of Land Surveyors or by a Decree of a Court of Law; established, re-established, monumented, re-monumented, recovered, found as expressed below:

NOTE: Not more than 4 corners, all in the same town and range, may be recorded on this certificate.


A. Description of original monument and accessories and/or subsequent restoration:

- POST SET IN ORIGINAL GOVERNMENT SURVEY BY HERVEY PARKE, DEPUTY SURVEYOR IN FEBRUARY 1826 AND TWO BEARING TREES RECORDED:
W.O. 20" N89-1/2W 63 LKS (41.6')
W.O. 24" S63E 19-1/2 LKS (12.9')

CONTINUED ON BACK

B. Description of corner evidence found and/or method applied in restoring or reestablishing corner:

SEARCHED AT APPARENT LOCATION OF CORNER AND FOUND 1/2" BAR AND CAP #17640 AT SOUTH SIDE OF ANCHOR POST. EXCAVATED ALL AROUND AND FOUND MANY SMALL STONES AND ONE DISTINCTIVE STONE 15" X 8" X 8" SQUARE WITH CROSS IN TOP, LAYING ON ITS SIDE NEXT TO SOUTH SIDE OF POST. ACCEPTED POST AND STONE AS CORNER AND SET STANDARD MARKER FOR PA 345 REMONUMENTATION IN INGHAM COUNTY NEXT TO 1/2" BAR AND ABOVE IT. MEASURED NORTH 2652.55 TO K-8.

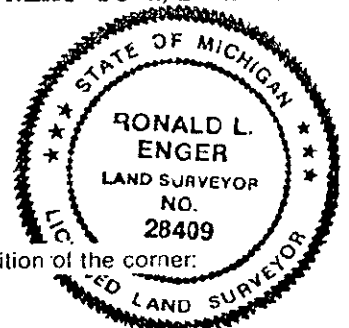

C. Description of monument for corner and accessories established to perpetuate locating the position of the corner:

- K-9 T2N R1W
3/4" X 24" LONG SMOOTH STEEL BAR AND YELLOW PLASTIC CAP IMPRINTED "PA 345 PS 28409" AT SOUTH SIDE OF ANCHOR POST.
NAIL AND TAG #17640 IN EAST SIDE OF 8" ASH IN CLUMP, 180° NAZ., 22.62'
NAIL AND TAG #17640 IN WEST SIDE OF 10" CHERRY, 176° NAZ., 36.32'
SET 20D GALVANIZED SPIKE AND TAG PS 28409 IN SOUTH SIDE OF 8" CHERRY, 79° NAZ., 37.24'
SET 20D GALVANIZED SPIKE AND TAG PS 28409 IN EAST SIDE OF 20" CHERRY, 0° NAZ., 78.18'

Signed by Ronald L. Enger Date NOVEMBER 29, 1996
Surveyor's Michigan License No. 28409

P.A. 345 INGHAM COUNTY
PEER APPROVED: 10/31/96 M

K-9 T2N R1W

PART A CONTINUED

2. A. P. DRAKE, DEPUTY COUNTY SURVEYOR, USED CORNER IN A SURVEY IN DECEMBER 1882, RECORDED IN VOLUME 3, PAGE 191 WITH THE FOLLOWING WITNESSES:

STONE

MAPLE 24" S5-1/2E 34 LKS (22.44')

3. G. YOUNG, PS #17640, RECORDED CORNER IN SEPTEMBER 1986 IN LIBER 6 OF CORNERS, PAGE 300 AND USED IN AN ACT 132 SURVEY RECORDED IN LIBER 5, PAGE 59 AS A 1/2" BAR AND CAP AT ANCHOR POST WITH THE FOLLOWING WITNESSES:

NAIL AND TAG IN SOUTH SIDE OF 10" ELM, WEST 21.30'

NAIL AND TAG IN WEST SIDE OF 14" CHERRY, NORTH 78.12'

NAIL AND TAG IN NORTHSOUTH SIDE OF 18" ELM, N20E, 86.00'

NAIL AND TAG IN WEST SIDE OF 8" ASH, SOUTH 23.30'

4. M. MAHIEU, PS #28414 RECORDED CORNER IN LIBER 7, PAGE 206, IN NOVEMBER 1990 AND AN ACT 132 SURVEY IN JULY 1989, RECORDED IN LIBER 5, PAGE 1088 WITH THE FOLLOWING WITNESSES:

1/2" ROD WITH CAP #17640 AT ANCHOR POST

NAIL AND TAG IN EAST SIDE OF CLUMP OF ASH, SOUTH, 22.79'

NAIL AND TAG IN WEST SIDE OF 10" CHERRY, S10E, 36.44'

NAIL AND TAG IN EAST SIDE OF 6" BOX ELDER, S25E, 18.23'

NAIL AND TAG IN WEST SIDE OF 6" ELM, S20W, 37.80'