

LAND CORNER RECORDATION CERTIFICATE
Filing Requirement of Act 74, Mich. P.A. 1970

For corners in

INGHAM (County)

Located In:

Corner Code #

VEVAY TOWNSHIP

1. Public Land Survey

T 2N R 1W K-10

2. Property Controlling in Section


S T

3. Miscellaneous Property in Sec.

S T

4. Lot No. , Recorded Plat

5. Private Claims

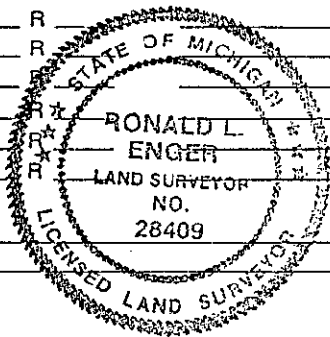

FILED

11/28/1995 09:37:01
REGISTER OF DEEDS
PAULA JOHNSON
INGHAM COUNTY, MI

Register of Deeds Stamp & File Number


I, RONALD L. ENGER in a field survey on OCTOBER 18, 1995, do hereby certify that under requirements of P.A. 74, Michigan P.A. of 1970, the corner points mentioned in lines 1 and 2 above were in conformance with regulations and rules therefore as required in the current manual of survey instructions of the United States Department of the Interior, Bureau of Land Management or by a decree of a Court of Law and/or that the corner points mentioned in lines 3, 4 and 5 above were in conformance with the rules of the Michigan Board of Land Surveyors or by a Decree of a Court of Law; established, re-established, monumented, re-monumented, recovered, found as expressed below:

NOTE: Not more than 4 corners, all in the same town and range, may be recorded on this certificate.

A. Description of original monument and accessories and/or subsequent restoration:

1. POST SET IN ORIGINAL GOVERNMENT SURVEY BY HERVEY PARKE, DEPUTY SURVEYOR, IN FEBRUARY 1826 AND TWO BEARING TREES RECORDED:
W. OAK 20" S53W 15 LKS
W. OAK 18" S88E 23 LKS

CONTINUED ON BACK

B. Description of corner evidence found and/or method applied in restoring or reestablishing corner:

SEARCHED AT APPARENT LOCATION OF CORNER AND FOUND 1/2" BAR AND CAP #17640 AT SOUTHWEST SIDE FENCE CORNER FOR 10' HIGH DEER YARD FENCE WITH OLD ANCHOR POST LAYING 10' TO SOUTHEAST. EXCAVATED AROUND POST ON THREE SIDES AND FOUND ONLY ORDINARY FENCE POST STONES. ACCEPTED BAR AND CAP AS PERPETUATION OF CORNER AND SET STANDARD MARKER FOR PA 345 REMONUMENTATION IN INGHAM COUNTY IN ITS PLACE.

C. Description of monument for corner and accessories established to perpetuate locating the position of the corner:

K-10 T2N R1W
3/4" DIAMETER X 24" LONG SMOOTH STEEL BAR AND CAP IMPRINTED "PA 345 PS 28409" AT SOUTHWEST SIDE FENCE POST
NAIL AND TAG 18998 IN WEST SIDE OF 15" OAK, 25° NAZ., 13.60'
NAIL AND TAG 18998 IN WEST SIDE OF 19" RED OAK, 156° NAZ., 33.85'
NAIL AND TAG 18998 IN WEST SIDE OF 17" WHITE OAK, 188° NAZ., 9.60'
SET 20D GALVANIZED SPIKE AND TAG PS 28409 IN SOUTH SIDE OF 15" WHITE OAK, 250° NAZ., 22.75'
NAIL AND TAG 17640 IN EAST SIDE OF 16" WHITE OAK, 332° NAZ., 37.30'

Signed by [Signature]

Date NOVEMBER 2, 1995

Surveyor's Michigan License No. 28409

K-10 T2N R1W
PART A CONTINUED

2. A. P. DRAKE, COUNTY SURVEYOR, USED CORNER IN DECEMBER 1882 IN SURVEY RECORDED IN VOLUME 3, PAGE 191 WITH THE FOLLOWING WITNESSES:

POST
W. O. 18" S88E 23

3. E. A. CALKINS, COUNTY SURVEYOR, USED CORNER IN JUNE 1902 IN SURVEY RECORDED IN VOLUME 5, PAGE 30 WITH THE FOLLOWING WITNESSES:

OLD POST AND STUMP OF OLD BEARING
W. OAK 5" N3W 8-1/2 LKS (5.6')

4. G. YOUNG, PS 17640, USED CORNER IN AN ACT 132 SURVEY IN JULY 1985 RECORDED IN LIBER 4, PAGE 1113 AS A SET 1/2" IRON AND CAP IN CENTER OF ANCHOR POST WITH THE FOLLOWING WITNESSES:

NAIL AND TAG SOUTH SIDE 12" OAK SW 23.20'
NAIL AND TAG WEST SIDE 12" OAK S 9.75'
NAIL AND TAG WEST SIDE 6" POPLAR SE 19.85'
NAIL AND TAG WEST SIDE 10" OAK NE 13.70'

5. M. MAHIEU, PS 28414, RECORDED CORNER IN LIBER 7, PAGE 135 IN JULY 1989 AND USED IN AN ACT 132 SURVEY RECORDED IN LIBER 6, PAGE 114 IN FEBRUARY 1990 AS A FOUND 1/2" IRON ROD AS RECORDED IN LIBER 4, PAGE 1113 WITH THE FOLLOWING WITNESSES:

NAIL AND TAG WEST SIDE 24" OAK S10°W 10.08'
NAIL AND TAG SOUTHWEST SIDE 18" POPLAR S45E 20.12'
NAIL AND TAG NORTH SIDE 18" OAK N10E 13.52'
NAIL AND TAG EAST SIDE 24" OAK N20W 37.30'

6. R. LESTER, PS 18998, USED CORNER IN AN ACT 132 SURVEY IN FEB. 1990 RECORDED IN LIBER 6 PAGE 114 AS A FOUND 1/2" BAR & CAP # 17640

NAIL & TAG EAST SIDE 24" OAK, 332° AZ., 37.30'
NAIL & TAG WEST SIDE 15" OAK, 193° AZ., 10.1'
NAIL & TAG WEST SIDE 12" OAK, 22° AZ., 13.5'
NAIL & TAG WEST SIDE 24" OAK, 156° AZ., 34.0'

RECORDED
INDEXED
SERIALIZED
FILED