

LAND CORNER RECORDATION CERTIFICATE
Filing Requirement of Act 74, Mich. P.A. 1970

For corners in

INGHAM (County)

Located In:

Corner Code ##

VEVAY TOWNSHIP

1. Public Land Survey

T-2N R-1W K-11

2. Property Controlling in Section


S T B

3. Miscellaneous Property in Sec.

S T

4. Lot No. , Recorded Plat

5. Private Claims

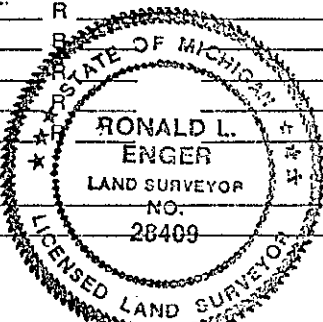

FILED

11/28/1995 09:37:02
REGISTER OF DEEDS
PAULA JOHNSON
INGHAM COUNTY, MI

Register of Deeds Stamp & File Number

Grid table with columns A-M and rows 1-13. Cell J11 contains a circled '7'.

I, RONALD L. ENGER in a field survey on OCTOBER 11, 19 95, do hereby certify that under requirements of P.A. 74, Michigan P.A. of 1970, the corner points mentioned in lines 1 and 2 above were in conformance with regulations and rules therefore as required in the current manual of survey instructions of the United States Department of the Interior, Bureau of Land Management or by a decree of a Court of Law and/or that the corner points mentioned in lines 3, 4 and 5 above were in conformance with the rules of the Michigan Board of Land Surveyors or by a Decree of a Court of Law; established, re-established, monumented, re-monumented, recovered, found as expressed below:

NOTE: Not more than 4 corners, all in the same town and range, may be recorded on this certificate.

A. Description of original monument and accessories and/or subsequent restoration:

1. POST SET IN ORIGINAL GOVERNMENT SURVEY BY HERVEY PARKE, DEPUTY SURVEYOR, IN FEBRUARY 1826 AND TWO BEARING TREES RECORDED:
W. OAK 12" S6W 28 LKS
MAPLE 7" N7W 28 LKS

CONTINUED ON BACK

B. Description of corner evidence found and/or method applied in restoring or reestablishing corner:

SEARCHED AT APPARENT LOCATION OF CORNER AND FOUND 1/2" BAR AND CAP #3276 IN MONUMENT BOX 2' SOUTH OF CENTERLINE OF BARNES ROAD ON FENCE LINES NORTH AND SOUTH. PULLED IRON AND EXCAVATED BOTTOM OF BOX WITH POST HOLE DIGGERS. EXCAVATED INTO NATURAL GROUND AND FOUND NOTHING MORE. AS CORNER IS IN A 10' CUT AREA OF ROAD CHANCES OF FINDING ANY HISTORICAL EVIDENCE ARE NON EXISTENT. ACCEPTED BAR AND CAP AS PERPETUATION OF CORNER AND REPLACED IT WITH STANDARD BAR AND CAP FOR REMONUMENTATION IN INGHAM COUNTY.

C. Description of monument for corner and accessories established to perpetuate locating the position of the corner:

K-11 T2N R1W
3/4" DIAMETER X 24" LONG SMOOTH STEEL BAR AND CAP IMPRINTED "PA 345 PS 28409" IN MONUMENT BOX.
NAIL AND TAG(NO TEXT) IN SOUTH SIDE OF 40" MAPLE, 87° NAZ., 278.65'
NAIL AND TAG #25832 IN SOUTH SIDE OF 6" POPLAR, 75° NAZ., 88.30'
NAIL AND TAG #28414 IN SOUTHEAST SIDE OF 4" POPLAR, 37° NAZ., 31.35'
NAIL AND TAG #18998 IN EAST SIDE OF UTILITY POLE, 202° NAZ., 32.32'
NAIL AND TAG #28414 IN SOUTH SIDE OF 10" ELM, 240° NAZ., 50.50'

Signed by [Signature] 28409

Date NOVEMBER 2, 1995

Surveyor's Michigan License No.

FORM APPROVED BY MICHIGAN STATE BOARD OF LAND SURVEYORS, JAN. 28, 1971
REVISED MAY 14, 1975
REVISED JAN. 1983

P.A. 345 INGHAM COUNTY
PEER APPROVED: 11/21/95 MC

K-11 T2N R1W
PART A CONTINUED

2. A. JACKSON, COUNTY SURVEYOR, USED CORNER IN NOVEMBER 1866 RECORDED IN VOLUME 2, PAGE 303 WITH THE SAME MONUMENTS AND WITNESSES AS PART A-1.
3. A. P. DRAKE USED CORNER IN DECEMBER 1882 RECORDED IN VOLUME 3, PAGE 191 OF COUNTY SURVEY RECORDS WITH NO MENTION OF MONUMENT OR WITNESSES.
4. THE PRIVATE RECORDS (DATE UNKNOWN) OF LAVERNE HENDRYX LS #3276 (NOW IN THE POSSESSION OF ACCOLADE SURVEYING) CALL FOR CORNER AS A SET #4 BAR FROM PAST SURVEYS.
5. F. WHITE, PS #12034, RECORDED CORNER IN MARCH 1977 IN LIBER 4 OF CORNERS, PAGE 6 AS A FOUND IRON AND CAP #3276 2' SOUTH OF CENTERLINE PAVEMENT WITH THE FOLLOWING WITNESSES:
NAIL AND TAG 36" OAK N83E 278.65'
IRON AND CAP #3276 SOUTH 33.00'
6. GEORGE YOUNG, PS #17640, USED CORNER IN AN ACT 132 SURVEY IN JULY 1985 RECORDED IN LIBER 4, PAGE 1113 WITH THE SAME MONUMENTS AND WITNESSES AS PART A-4.
7. R. LESTER, PS 18998, USED CORNER IN AN ACT 132 SURVEY RECORDED IN LIBER 6 PAGE 114 AS A BAR & CAP IN MONUMENT BOX
FOUND BAR & CAP #17640, 05° AZ, 33.0'
FOUND BAR & CAP #3276, 185° AZ, 32.8'
SET NAIL & TAG IN E. SIDE UTIL. POLE, 203° AZ, 32.4'
SET NAIL & TAG IN S. SIDE 20" BUTTERNUT, 88° AZ 247.6'
7. R. HELSEL, PS 18994, USED CORNER IN AN ACT 132 SURVEY RECORDED IN LIBER 7, PAGE 388 IN JUNE 1994 AS A FOUND BAR AND CAP #3276 IN MONUMENT BOX WITH THE FOLLOWING WITNESSES:
NAIL AND TAG 28414 EAST SIDE 4" POPLAR N35°E 31.41'
NAIL AND TAG 28414 NORTH SIDE 12" ELM S55°W 50.54'
NAIL AND TAG 18998 EAST SIDE UTILITY POLE S15°W 32.18'
NAIL AND TAG 25832 SOUTH SIDE 10" POPLAR N65°E 88.24'

