


LAND CORNER RECORDATION CERTIFICATE
Filing Requirement of Act 74, Mich. P.A. 1970

For corners in

INGHAM (County)
VEVAY TOWNSHIP

Located In: Corner Code #

- 1. Public Land Survey T 2N R 1W L-7
2. Property Controlling in Section S T
3. Miscellaneous Property in Sec. S T
4. Lot No. Recorded Plat
5. Private Claims

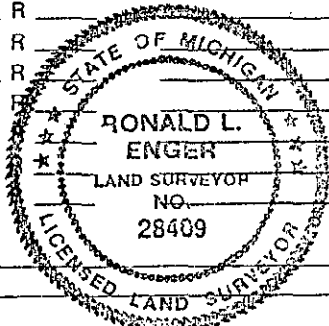

FILED
11/28/1995 09:37:04
REGISTER OF DEEDS
PAULA JOHNSON
INGHAM COUNTY, MI

Register of Deeds Stamp & File Number

Grid table with columns A-M and rows 1-13, containing numbers 1-36.

I, RONALD L. ENGER, in a field survey on OCTOBER 11, 1995, do hereby certify that under requirements of P.A. 74, Michigan P.A. of 1970, the corner points mentioned in lines 1 and 2 above were in conformance with regulations and rules therefore as required in the current manual of survey instructions of the United States Department of the Interior, Bureau of Land Management or by a decree of a Court of Law and/or that the corner points mentioned in lines 3, 4 and 5 above were in conformance with the rules of the Michigan Board of Land Surveyors or by a Decree of a Court of Law; established, re-established, monumented, re-monumented, recovered, found as expressed below:

NOTE: Not more than 4 corners, all in the same town and range, may be recorded on this certificate.

A. Description of original monument and accessories and/or subsequent restoration:

1. POST SET IN ORIGINAL GOVERNMENT SURVEY BY HERVEY PARKE, DEPUTY SURVEYOR IN FEBRUARY 1826 AND TWO BEARING TREES RECORDED:
Y. OAK, 20" S15W 8 1/2 LKS
W. OAK, 10" N32W 41 LKS

CONTINUED ON BACK

B. Description of corner evidence found and/or method applied in restoring or reestablishing corner:

SEARCHED AT APPARENT LOCATION OF CORNER AND FOUND RAILROAD SPIKE AS RECORDED, 1/4" REBAR 5.5' SOUTHEAST OF RAILROAD SPIKE AND DEEP MAGNETIC READING 92° NAZ., 2.00' FROM RAILROAD SPIKE. EXCAVATED READING AND FOUND STONE LYING ON TOP OF AXLE AND SPINDLE GEAR SURROUNDED BY BROKEN BRICK AND CROCKERY AS REPORTED BY W. L. PADISON IN 1961. ACCEPTED AXLE AS PERPETUATION OF CORNER. REMOVED STONE AND ACCORDINGLY SET STANDARD MARKER FOR PA 345 REMONUMENTATION IN INGHAM COUNTY ON TOP OF AXLE IN CONCRETE AND MONUMENT BOX. REMOVED 1/4" BAR.

C. Description of monument for corner and accessories established to perpetuate locating the position of the corner:

L-7 T2N R1W
3/4" DIAMETER X 24" LONG SMOOTH STEEL BAR AND CAP IMPRINTED "PA 345 PS 28409" IN MONUMENT BOX 1' EAST OF CENTERLINE DIAMOND ROAD ON FENCE LINE WEST RAILROAD SPIKE 272° NAZ., 2.00'
4" CONCRETE-FILLED STEEL FENCE POST SET IN CONCRETE 270° NAZ., 30.21' NAIL AND TAG #28409 IN WEST SIDE OF 10" OAK, 136° NAZ., 48.46'
NAIL AND TAG #28414 IN NORTHWEST SIDE OF 12" RED PINE, 86° NAZ., 45.96'
NAIL AND TAG #28414 IN SOUTHEAST SIDE OF 16" RED PINE 47° NAZ., 52.89"
1/2" BAR AND CAP #18994 (R. HELSEL), 90° NAZ., 30.96'

Signed by [Signature] Date OCTOBER 20, 1995
Surveyor's Michigan License No. 28409

L-7 T2N R1W
PART A CONTINUED

2. A. JACKSON, COUNTY SURVEYOR USED CORNER IN JUNE 1839 AND JULY 1839 VOLUME 1, PAGE 36 AND 39 INGHAM COUNTY SURVEY RECORDS WITH NO MENTION OF MONUMENTS AND WITNESSES.
3. W. L. PADISON, PS 7256, DEPARTMENT OF CONSERVATION SURVEYOR FOUND STONE SURROUNDED BY CROCKERY AND BRICK IN FEBRUARY 1961. SET 33" AXLE WITH GEAR IN CROCKERY AND BRICK AND PUT STONE ON TOP OF GEAR.
4. J. STEPHENS, PS 16053 RECORDED CORNER IN NOVEMBER 1973 LIBER 2 CORNERS, PAGE 591 AND USED IN A SURVEY IN JUNE 1973 RECORDED IN LIBER 1 OF SURVEYS, PAGE 815 WITH THE FOLLOWING WITNESSES:
R. R. SPIKE
SURVEY TAG IN SOUTH SIDE OF 30" MAPLE, N8° 37'E 151.05'
SURVEY TAG IN EAST SIDE U.P. N88° 39'W 54.97'
N89° 53'W 24.95' TO CENTERLINE 4" METAL FENCE POST
5. R. LESTER, PS 18998 USED CORNER IN MAY 1975 LIBER 2 OF SURVEYS, PAGE 448 WITH SAME MONUMENTS AND WITNESSES AS PART A #3.
6. G. YOUNG, PS 17640 USED CORNER IN NOVEMBER 1978 LIBER 3 OF SURVEYS, PAGE 617 WITH SAME MONUMENTS AND WITNESSES AS PART A #3.
7. M. MAHIEU PS 28414 RECORDED CORNER IN APRIL 1990 IN LIBER 7, PAGE 204 AS A FOUND RAILROAD SPIKE WITH THE FOLLOWING WITNESSES:
NAIL AND TAG IN NORTH SIDE OF 18" ELM, S85°W 30.42'
NAIL AND TAG IN NORTH SIDE OF 12" PINE, N85°E 48.00'
NAIL AND TAG IN SOUTH SIDE OF 12" PINE, N40°E 54.00'
NAIL AND TAG IN SOUTHWEST SIDE OF 6" OAK, S15°E 115.77'
8. R. HELSEL PS 18989 USED CORNER IN AN UNRECORDED SURVEY IN THE NE 1/4 SECTION 24 T2N, R1W IN OCTOBER 1994.

