

LAND CORNER RECORDATION CERTIFICATE
Filing Requirement of Act 74, Mich. P.A. 1970

For corners in


INGHAM (County)
VEVAY TOWNSHIP

Located In: Corner Code ##

FILED

12/06/1995 08:38:34
REGISTER OF DEEDS
PAULA JOHNSON
INGHAM COUNTY, MI

- 1. Public Land Survey T 2N R 1W L-11
2. Property Controlling in Section S T R
3. Miscellaneous Property in Sec. S T R
4. Lot No. Recorded Plat
5. Private Claims

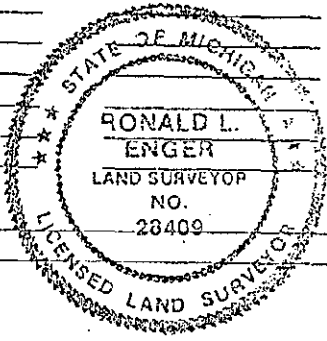

Register of Deeds Stamp & File Number

Grid table with columns A-L and rows 1-13, containing numbers 1-36.

1. RONALD L. ENGER in a field survey on OCTOBER 16, 19 95 do hereby certify that under requirements of P.A. 74, Michigan P.A. of 1970, the corner points mentioned in lines 1 and 2 above were in conformance with regulations and rules therefore as required in the current manual of survey instructions of the United States Department of the Interior, Bureau of Land Management or by a decree of a Court of Law and/or that the corner points mentioned in lines 3, 4 and 5 above were in conformance with the rules of the Michigan Board of Land Surveyors or by a Decree of a Court of Law; established, re-established, monumented, re-monumented, recovered, found as expressed below:

NOTE: Not more than 4 corners, all in the same town and range, may be recorded on this certificate.

A. Description of original monument and accessories and/or subsequent restoration:

1. POST SET IN ORIGINAL GOVERNMENT SURVEY BY HERVEY PARKE, DEPUTY SURVEYOR IN FEBRUARY 1826 AND TWO BEARING TREES RECORDED:
ELM 11" S79E 225-1/2 LKS
ASPEN 6" N81E 221 LKS

CONTINUED ON BACK

B. Description of corner evidence found and/or method applied in restoring or reestablishing corner:

SEARCHED AT APPARENT LOCATION OF CORNER AND FOUND 1/2" BAR 1.5' NORTH OF CENTERLINE OF BARNES ROAD ON FENCELINE NORTH AND SOUTH. EXCAVATED 2' X 2' HOLE 2' DEEP AND FOUND POINTED STONE IN HOLE IN SECOND BITUMINOUS SURFACE 0.85 SOUTHWEST OF 1/2" BAR. ACCEPTED STONE AS PERPETUATION OF CORNER AND SET STANDARD MARKER FOR PA 345 REMONUMENTATION IN INGHAM COUNTY ON TOP OF IT AND SET MONUMENT BOX. AFTER REFLECTING ON THE SITUATION AND CONSULTATION WITH PEER GROUP AND MAYNARD DYER DECIDED THAT 1/2" BAR WAS IN CLOSE ENOUGH PROXIMITY TO STONE TO ACCEPT AS OCCUPYING PERPETUATED LOCATION OF CORNER. MOVED STANDARD MONUMENT AND MONUMENT BOX TO LOCATION OF 1/2" BAR.

C. Description of monument for corner and accessories established to perpetuate locating the position of the corner:

L-11 T2N R1W
3/4" DIAMETER X 24" LONG SMOOTH STEEL BAR AND CAP IMPRINTED "PA 345 PA 28409" IN MONUMENT BOX 1.0' NORTH OF CENTERLINE OF BARNES ROAD ON FENCELINE NORTH AND SOUTH.
NAIL AND TAG 18998 IN TOP OF CORNER FENCE POST 3° NAZ., 36.14'
NAIL AND TAG 18998 IN TOP OF FENCE POST 13° NAZ., 36.17'
NAIL AND TAG 18998 IN TOP OF RAILROAD TIE FENCE POST 180° NAZ., 40.52'
SET 20D GALVANIZED SPIKE AND TAG PS 28409 IN WEST SIDE OF 17" OAK, 156° NAZ., 79.93'
SET 20D GALVANIZED SPIKE AND TAG PS 28409 IN WEST SIDE OF 9" OAK, 169° NAZ., 80.98'

Signed by [Signature] Date DECEMBER 5, 1995
Surveyor's Michigan License No. 28409

L-11 T2N R1W  
PART A CONTINUED

2. A. JACKSON, COUNTY SURVEYOR, USED CORNER IN NOVEMBER 1866 RECORDED IN VOLUME 2, PAGE 303 WITH THE SAME MONUMENTS AND WITNESSES AS PART A-1.

3. A. P. DRAKE, COUNTY SURVEYOR, USED CORNER IN OCTOBER 1882 RECORDED IN VOLUME 3, PAGE 191 OF COUNTY SURVEY RECORDS AS POST IN CENTER OF HIGHWAY.

4. E. A. CALKINS, COUNTY SURVEYOR, USED CORNER IN DECEMBER 1899 IN A SURVEY RECORDED IN VOLUME 5, PAGE 6 WITH THE FOLLOWING WITNESSES:  
POST IN SECTION OF TILE SURROUNDED BY STONE AND CROCKERY  
ELM 5" S44°E 58 (38.3')  
ELM 8" N52-1/2W 62 (40.9')

5. MAYNARD DYER, PS 21565, RECORDED CORNER IN JANUARY 1976 IN LIBER 3, PAGE 517 AND USED IN AN ACT 132 SURVEY IN DECEMBER 1975 RECORDED IN LIBER 2, PAGE 606 AS SET 1/2" BAR AND CAP 2' NORTH OF CENTERLINE OF BARNES ROAD ON FENCE LINE NORTH AND SOUTH WITH THE FOLLOWING WITNESSES:  
NAIL AND TAG IN NORTH SIDE 15" OAK S80°E 246.90'  
NAIL AND TAG IN EAST SIDE OF 18" OAK S15°E 79.64'

6. R. LESTER, PS 18998, USED CORNER IN AN ACT 132 SURVEY RECORDED IN LIBER 6, PAGE 708 IN APRIL 1991 AS A 1/2" BAR WITH THE FOLLOWING WITNESSES:  
NAIL AND TAG IN TOP OF RAILROAD TIE FENCE POST 181° NAZ., 40.5'  
NAIL AND TAG IN TOP OF RAILROAD TIE FENCE POST 113° NAZ., 117.2'  
NAIL AND TAG IN TOP OF FENCE POST 3° NAZ., 36.1'  
NAIL AND TAG IN TOP OF FENCE POST 13° NAZ., 36.1'

7. R. HELSEL, PS 18994, USED CORNER IN AN ACT 132 SURVEY RECORDED IN LIBER 7, PAGE 388 IN JUNE 1994 AS A FOUND 1/2" BAR WITH THE FOLLOWING WITNESSES:  
NAIL AND TAG #18998 TOP WOOD FENCE POST NORTH 36.21'  
NAIL AND TAG #18998 TOP WOOD FENCE POST N10°E 36.11'  
NAIL AND TAG #18998 RAILROAD TIE FENCE POST S03°E 40.49'  
NAIL AND TAG #18998 NORTH SIDE 12" POPLAR S75°E 79.15'