

LAND CORNER RECORDATION CERTIFICATE
Filing Requirement of Act 74, Mich. P.A. 1970

For corners in

INGHAM (County) Located In: Corner Code #
1. Public Land Survey T--2N R--1W M--7
2. Property Controlling in Section S T R
3. Miscellaneous Property in Sec. S T R

FILED
11/28/1995 09:37:08
REGISTER OF DEEDS
PAULA JOHNSON
INGHAM COUNTY, MI

Register of Deeds Stamp & File Number

- 4. Lot No. , Recorded Plat
5. Private Claims

Grid table with columns A-L and rows 2-13 containing numbers 1-36.

I, RONALD L. ENGER in a field survey on OCTOBER 11, 19 95, do hereby certify that under requirements of P.A. 74, Michigan P.A. of 1970, the corner points mentioned in lines 1 and 2 above were in conformance with regulations and rules therefore as required in the current manual of survey instructions of the United States Department of the Interior, Bureau of Land Management or by a decree of a Court of Law and/or that the corner points mentioned in lines 3, 4 and 5 above were in conformance with the rules of the Michigan Board of Land Surveyors or by a Decree of a Court of Law; established, re-established, monumented, re-monumented, recovered, found as expressed below:

NOTE: Not more than 4 corners, all in the same town and range, may be recorded on this certificate.


A. Description of original monument and accessories and/or subsequent restoration:

1. POST SET IN ORIGINAL GOVERNMENT SURVEY BY JOSEPH WAMPLER, DEPUTY SURVEYOR ON FEBRUARY 7, 1824 AND TWO BEARING TREES RECORDED:
ASH, 11" S70 1/2W 14 LKS
ASH, 11" N18 1/2W 17 LKS

CONTINUED ON BACK

B. Description of corner evidence found and/or method applied in restoring or reestablishing corner:

SEARCHED AT APPARENT LOCATION OF CORNER AND FOUND R. STEADMAN'S PIPE IN OLD FENCE POST HOLE. EXCAVATED ALL AROUND PIPE AND FOUND MANY SMALL STONES AND 1 SQUARE CUT STONE (24" X 10" X 10") NORTH SIDE OF PIPE LAYING DOWN. ACCEPTED PIPE AND STONE AS PERPETUATION OF CORNER AND DROVE STANDARD MARKER FOR PA 345 REMONUMENTATION IN INGHAM COUNTY INTO TOP OF PIPE.

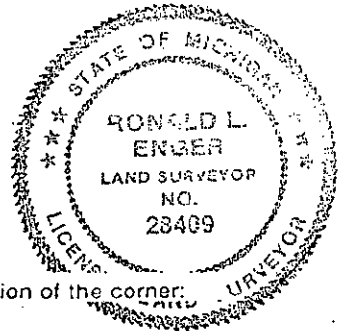

C. Description of monument for corner and accessories established to perpetuate locating the position of the corner:

M-7 T2N R1W
3/4" DIAMETER X 24" LONG SMOOTH STEEL BAR AND CAP IMPRINTED "PA 345 PS 28409" IN PIPE BY STONE IN FENCE POST HOLE.
SET 20D GALVANIZED SPIKE AND TAG PS 28409 IN EAST SIDE OF 14" TRIPLE TRUNK MAPLE, 301° NAZ., 62.22'
NAIL AND TAG 18994 IN WEST SIDE OF 27" MAPLE, 31° NAZ., 25.11'
NAIL AND TAG 18994 IN NORTH SIDE OF 9" ASH, 267° NAZ., 21.40'
NAIL AND TAG 18994 IN NORTH SIDE OF 30" OAK, 94° NAZ., 32.90'

Signed by [Signature] Date OCTOBER 20, 1995
Surveyor's Michigan License No. 28409

M-7 T2N R1W
PART A CONTINUED

2. R. STEADMAN, PS 11370 RECORDED CORNER IN NOVEMBER 1976 IN LIBER 4 OF CORNERS, PAGE 1 AND USED IN A SURVEY IN NOVEMBER 1976, RECORDED IN LIBER 2 OF SURVEYS, PAGE 949. SET 3/4" PIPE IN OLD ANCHOR POST HOLE WITH THE FOLLOWING WITNESSES:

FENCES NORTH, SOUTH AND WEST

6" ASH, N80°W, 32.60'

26" OAK, SOUTH, 11.49'

14" MAPLE N11E, 24.83'

28" OAK, S63W, 32.91'

3. G. YOUNG, PS 17640 USED CORNER IN NOVEMBER 1978 RECORDED IN LIBER 3 OF SURVEYS, PAGE 617 WITH THE SAME MONUMENTS AND WITNESSES AS PART A #2.

Only the
first page
of the
original
is shown.