

LAND CORNER RECORDATION CERTIFICATE
Filing Requirement of Act 74, Mich. P.A. 1970

For corners in

INGHAM (County) Located In: Corner Code ##
1. Public Land Survey T 2N R 1W M-9
2. Property Controlling in Section S T R
3. Miscellaneous Property in Sec. S T R

EILED
11/28/1995 09:37:11
REGISTER OF DEEDS
PAULA JOHNSON
INGHAM COUNTY, MI
Register of Deeds Stamp & File Number

4. Lot No. , Recorded Plat
5. Private Claims

I, RONALD L. ENGER in a field survey on OCTOBER 16, 19 95, do hereby certify that under requirements of P.A. 74, Michigan P.A. of 1970, the corner points mentioned in lines 1 and 2 above were in conformance with regulations and rules thereore as required in the current manual of survey instructions of the United States Department of the Interior, Bureau of Land Management or by a decree of a Court of Law and/or that the corner points mentioned in lines 3, 4 and 5 above were in conformance with the rules of the Michigan Board of Land Surveyors or by a Decree of a Court of Law; established, re-established, monumented, re-monumented, recovered, found as expressed below:

NOTE: Not more than 4 corners, all in the same town and range, may be recorded on this certificate.


A. Description of original monument and accessories and/or subsequent restoration:

1. POST SET IN ORIGINAL GOVERNMENT SURVEY BY JOSEPH WAMPLER, DEPUTY SURVEYOR ON FEBRUARY 7, 1824 AND TWO BEARING TREES RECORDED:
TAM 11" N45-1/2W 39 LKS
TAM 5" S48W 32 LKS

CONTINUED ON BACK

B. Description of corner evidence found and/or method applied in restoring or reestablishing corner:

SEARCHED AT APPARENT LOCATION OF CORNER (FOUND APPARENT LOCATION OF CORNER BY FLAGGING EXTENSIONS OF FENCE LINES INTO SWAMP FROM NORTH AND WEST) AND FOUND 1/2" BAR AND CAP #21565 ON EXTENSION OF FENCE LINES. ACCEPTED 1/2" BAR AND CAP AS PERPETUATION OF CORNER BECAUSE OF AGREEMENT WITH ANCIENT OCCUPATION AND SET 36" X 1" GALVANIZED PIPE WITH PA 345 CAP IN ITS PLACE.

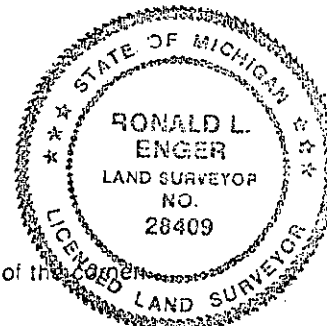

C. Description of monument for corner and accessories established to perpetuate locating the position of the

M-9 T2N R1W
1" DIAMETER X 36" LONG GALVANIZED PIPE WITH CAP IMPRINTED "PA 345 PS 28409"
SET 20D GALVANIZED SPIKE AND TAG PS 28409 IN WEST SIDE OF 6" MAPLE, 157° NAZ., 18.95'
SET 20D GALVANIZED SPIKE AND TAG PS 28409 IN WEST SIDE OF 20" MAPLE, 214° NAZ., 37.28'
SET 20D GALVANIZED SPIKE AND TAG PS 28409 IN NORTH SIDE OF 14" MAPLE, 247° NAZ., 34.66'
SET 20D GALVANIZED SPIKE AND TAG PS 28409 IN NORTH SIDE OF 21" MAPLE, 306° NAZ., 28.21'

Signed by: [Signature] Date: NOVEMBER 1, 1995
Surveyor's Michigan License No. 28409

M-9 T2N R1W
PART A CONTINUED

2. A. JACKSON, COUNTY SURVEYOR, USED CORNER IN JULY 1839 IN A SURVEY RECORDED IN VOLUME 1, PAGE 36 WITH THE SAME MONUMENTS AND WITNESSES AS IN PART A-1.
3. MAYNARD DYER, PS 21565 RECORDED CORNER IN JANUARY 1976 IN LIBER 3 OF CORNERS, PAGE 516 AND USED CORNER IN SURVEYS IN DECEMBER 1975 RECORDED IN LIBER 2 OF SURVEYS, PAGES 604-606 WITH THE FOLLOWING WITNESSES:
SET 1/2" BAR AND CAP AT INTERSECTION OF FENCES NORTH-SOUTH AND WEST
NAIL AND TAG NORTH SIDE OF 10" BIRCH, EAST-SOUTHEAST, 20.01'
NAIL AND TAG WEST SIDE OF 6" MAPLE, NORTH-NORTHEAST, 18.86'
NAIL AND TAG SOUTH SIDE OF 15" MAPLE, NORTHWEST, 27.92'
4. G. YOUNG, PS 17640 USED CORNER IN A SURVEY IN MAY 1976, RECORDED IN LIBER 2 OF SURVEYS, PAGE 714 WITH THE SAME MONUMENTS AND WITNESSES AS PART A-3.
5. R. LESTER, PS 18998 USED CORNER IN SURVEYS IN NOVEMBER AND DECEMBER 1977 RECORDED IN LIBER 3 OF SURVEYS, PAGES 196 AND 284 WITH THE SAME MONUMENTS AND WITNESSES AS PART A-3.
6. A. WILLIAMS, PS 21275 USED CORNER IN AN ACT 132 SURVEY IN JANUARY 1985, RECORDED IN LIBER 4, PAGE 1010 WITH THE SAME MONUMENTS AND WITNESSES AS PART A-3.

RECORDED
INDEXED
SERIALIZED
MAY 1985