

LAND CORNER RECORDATION CERTIFICATE
Filing Requirement of Act 74, Mich. P.A. 1970

For corners in

INGHAM (County) Located In: Corner Code #
1. Public Land Survey T 2N R 1W M-10
2. Property Controlling in Section S T R
3. Miscellaneous Property in Sec. S T R

EILED
11/28/1995 09:37:12
REGISTER OF DEEDS
PAULA JOHNSON
INGHAM COUNTY, MI
Register of Deeds Stamp & File Number

4. Lot No. , Recorded Plat
5. Private Claims

Grid table with columns A-L and rows 2-13. Contains numbers 1-35 in a grid pattern.

I, RONALD L. ENGER in a field survey on OCTOBER 18, 19 95, do hereby certify that under requirements of P.A. 74, Michigan P.A. of 1970, the corner points mentioned in lines 1 and 2 above were in conformance with regulations and rules therefore as required in the current manual of survey instructions of the United States Department of the Interior, Bureau of Land Management or by a decree of a Court of Law and/or that the corner points mentioned in lines 3, 4 and 5 above were in conformance with the rules of the Michigan Board of Land Surveyors or by a Decree of a Court of Law; established, re-established, monumented, re-monumented, recovered, found as expressed below:

NOTE: Not more than 4 corners, all in the same town and range, may be recorded on this certificate.


A. Description of original monument and accessories and/or subsequent restoration:

1. POST SET IN ORIGINAL GOVERNMENT SURVEY BY JOSEPH WAMPLER, DEPUTY SURVEYOR ON FEBRUARY 7, 1824 AND TWO BEARING TREES RECORDED:
ASH 16" N35W 23-1/2 LKS
BIRCH 9" S45W 32-1/2 LKS

CONTINUED ON BACK

B. Description of corner evidence found and/or method applied in restoring or reestablishing corner:

SEARCHED AT APPARENT LOCATION OF CORNER AND FOUND 1/2" BAR AND CAP #21565 IN SWAMP NEXT TO 4" X 4" TREATED WOOD POST. M. DYER'S ELM WITNESS TO EAST IS DEAD. ELM WITNESS TO NORTH IS GONE. FENCE 46' NORTH IS GONE. ACCEPTED 1/2" BAR AND CAP AS PERPETUATION OF CORNER AND REPLACED WITH STANDARD MARKER FOR PA 345 REMONUMENTATION IN INGHAM COUNTY.

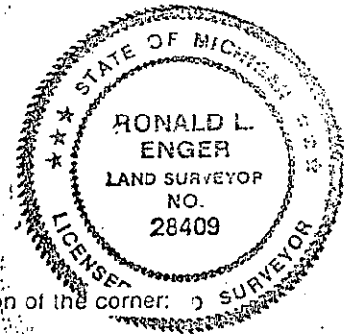

C. Description of monument for corner and accessories established to perpetuate locating the position of the corner:

M-10 T2N R1W
3/4" DIAMETER X 24" LONG SMOOTH STEEL BAR AND CAP IMPRINTED "PA 345 PS 28409" 1' WEST OF 4" X 4" TREATED WOOD POST 6' HIGH.
SET 20D GALVANIZED SPIKE AND TAG PS 28409 IN WEST SIDE OF 8" CHERRY, 15° NAZ., 48.75'
SET 20D GALVANIZED SPIKE AND TAG PS 28409 IN SOUTH SIDE OF 16" MAPLE, 316° NAZ., 59.68'
SET 20D GALVANIZED SPIKE AND TAG PS 28409 IN WEST SIDE OF 4" X 4" TREATED WOOD POST, 05° NAZ., 46.80'
SET 20D GALVANIZED SPIKE AND TAG PS 28409 IN EAST SIDE OF 8" POPLAR, 08° NAZ., 84.21'

Signed by [Signature] Date NOVEMBER 2, 1995
Surveyor's Michigan License No. 28409

M-10 T2N R1W
PART A CONTINUED

2. ANSON JACKSON, COUNTY SURVEYOR, USED CORNER IN A SURVEY RECORDED IN VOLUME 1, PAGE 48 OF COUNTY SURVEY RECORDS IN FEBRUARY 1843 WITH THE SAME MONUMENTS AND WITNESSES AS PART A-1.
3. MAYNARD DYER, PS 21565, RECORDED CORNER IN LIBER 3 OF CORNERS, PAGE 515 IN JANUARY 1976 AND USED IN SURVEYS RECORDED IN LIBER 2 OF SURVEYS, PAGES 604-606 IN DECEMBER 1975. SET 1/2" BAR AND CAP AT THE INTERSECTION OF THE EAST LINE OF SECTION 25 AND THE EAST-WEST 1/4 LINE AS FOUND MONUMENTED.
NAIL AND TAG SOUTH SIDE OF 8" ELM, EAST 12.83'
NAIL AND TAG EAST SIDE OF 8" ELM, NORTH 37.12'
OLD EAST-WEST FENCE, NORTH 46'
DYER MEASURED SOUTH 1317.31' TO 1/16 CORNER AND SOUTH 2628.40' TO M-11.
4. A. WILLIAMS, PS 21275, USED CORNER IN AN ACT 132 SURVEY IN JANUARY 1985 AND RECORDED IN LIBER 4, PAGE 1010 WITH THE SAME MONUMENTS AND WITNESSES AS PART A-3.
5. M. MAHIEU, PS 28414, USED CORNER IN AN ACT 132 SURVEY RECORDED IN LIBER 5, PAGE 987 IN FEBRUARY 1989 WITH THE SAME MONUMENTS AND WITNESSES AS PART A-3.

SEARCHED
SERIALIZED
INDEXED
FILED