


LAND CORNER RECORDATION CERTIFICATE
Filing Requirement of Act 74, Mich. P.A. 1970

For corners in

INGHAM (County)
VEVAY TOWNSHIP

Located In: Corner Code #

- 1. Public Land Survey T 2N R 1W M-11
2. Property Controlling in Section S T R
3. Miscellaneous Property in Sec. S T R
4. Lot No. Recorded Plat
5. Private Claims

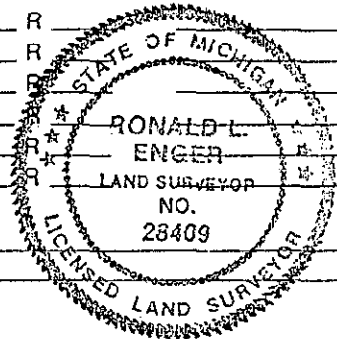

FILED
11/28/1995 09:37:14
REGISTER OF DEEDS
PAULA JOHNSON
INGHAM COUNTY, MI
Register of Deeds Stamp & File Number

Grid table with columns A-L and rows 1-13, containing numbers 1-36.

I, RONALD L. ENGER, in a field survey on OCTOBER 18, 1995, do hereby certify that under requirements of P.A. 74, Michigan P.A. of 1970, the corner points mentioned in lines 1 and 2 above were in conformance with regulations and rules therefore as required in the current manual of survey instructions of the United States Department of the Interior, Bureau of Land Management or by a decree of a Court of Law and/or that the corner points mentioned in lines 3, 4 and 5 above were in conformance with the rules of the Michigan Board of Land Surveyors or by a Decree of a Court of Law, established, re-established, monumented, re-monumented, recovered, found as expressed below:

NOTE: Not more than 4 corners, all in the same town and range, may be recorded on this certificate.

A. Description of original monument and accessories and/or subsequent restoration:

1. POST SET IN ORIGINAL GOVERNMENT SURVEY BY JOSEPH WAMPLER, DEPUTY SURVEYOR ON FEBRUARY 7, 1884 AND TWO BEARING TREES RECORDED:
ASH 16" S7W 60 LKS
ASH 6" N13W 68 LKS

CONTINUED ON BACK

B. Description of corner evidence found and/or method applied in restoring or reestablishing corner:

SEARCHED AT APPARENT LOCATION OF CORNER AND FOUND 1/2" BAR AND MUTILATED CAP IN MONUMENT BOX AT CENTERLINE OF INTERSECTION OF BARNES AND KELLY ROADS. PULLED IRON AND EXCAVATED BOTTOM OF BOX WITH POST HOLE DIGGERS. AT DEPTH OF 18" HIT SECOND BITUMINOUS SURFACE WITH STONE STICKING OUT OF IT IN NORTHWEST SIDE OF BOX. ACCEPTED STONE AS PERPETUATION OF CORNER AND SET STANDARD MARKER FOR PA 345 REMONUMENTATION IN INGHAM COUNTY IN PLACE OF 1/2" BAR NEXT TO STONE. ASSUMED THAT BAR WAS CLOSE ENOUGH TO STONE TO ACCEPT IT AS MONUMENT FOR CORNER.

C. Description of monument for corner and accessories established to perpetuate locating the position of the corner:

M-11 T2N R1W
3/4" DIAMETER X 24" LONG SMOOTH STEEL BAR AND CAP IMPRINTED "PA 345 PS 28409" IN MONUMENT BOX ON CENTERLINES OF BARNES AND KELLY ROADS.
NAIL AND TAG #18998 IN WEST SIDE OF 15" TWIN OAK, 140° NAZ., 63.90'
NAIL AND TAG #18994 IN WEST SIDE OF WOOD GUARD POST, 152° NAZ., 47.48'
SET 20D GALVANIZED SPIKE AND TAG #28409 IN EAST SIDE OF 36" OAK, 188° NAZ., 236.71'
PUNCH MARK IN EAST END OF 18" CMP, 10° NAZ., 218.50'
PUNCH MARK IN WEST END OF 18" CMP, 358° NAZ., 219.84'

Signed by [Signature] Date NOVEMBER 2, 1995

Surveyor's Michigan License No. 28409

M-11 T2N R1W
PART A CONTINUED

2. A. P. DRAKE, COUNTY SURVEYOR, USED CORNER IN DECEMBER 1882 IN A SURVEY RECORDED IN VOLUME 3, PAGE 191 WITH THE FOLLOWING WITNESSES:

POST

B. ASH 36" S19W 76 (50.2')
B. ASH 30" N57W 112 (73.9')

3. MAYNARD DYER, PS 21565, RECORDED CORNER IN JANUARY 1976 IN LIBER 4, PAGE 517 AND USED IT IN AN ACT 132 SURVEY IN DECEMBER 1975 RECORDED IN LIBER 2, PAGE 606 AS A SET 1/2" BAR AND CAP AT INTERSECTION OF SECTION LINE ROADS WITH THE FOLLOWING WITNESSES:

BOAT SPIKE IN NORTH SIDE 40" OAK, S60°W 139.53'
NAIL AND TAG NORTH SIDE 18" OAK, S30°W 135.32'
NAIL AND TAG EAST SIDE 6" OAK N30°W 62.87'

4. R. LESTER, PS 18998, USED CORNER IN AN ACT 132 SURVEY RECORDED IN LIBER 6, PAGE 708 IN APRIL 1991 WITH THE FOLLOWING WITNESSES:

1/2" BAR IN MONUMENT BOX

NAIL AND TAG NORTHWEST SIDE 30" OAK STUMP 211° NAZ., 135.2'
NAIL AND TAG NORTH SIDE 40" OAK 241° NAZ., 138.4'
NAIL AND TAG WEST SIDE 15" OAK 140° NAZ., 63.9'
NAIL AND TAG EAST SIDE 15" ASH 353° NAZ., 130.7'

5. R. HELSEL, PS 18994, USED CORNER IN AN ACT 132 SURVEY RECORDED IN LIBER 7, PAGE 378 IN OCTOBER 1994 AS A FOUND 1/2" IRON IN MONUMENT BOX WITH THE FOLLOWING WITNESSES:

NAIL AND TAG 18994 WEST SIDE WOOD POST S30°E 47.55'
NAIL AND TAG 18994 WEST SIDE WOOD POST N60°E 57.66'
NAIL AND TAG 18994 NORTHWEST SIDE RAILROAD TIE POST S20°W 89.49'
NAIL AND TAG 18994 EAST SIDE UTILITY POLE S45°W 97.78'

