

FILED

DEC 1 8 05 AM '94

REGISTER OF DEEDS
INGHAM COUNTY, MICH.

SURVEY &
REMONUMENTATION
APR 10 1995
COMMISSION

LAND CORNER RECORDATION CERTIFICATE
Filing Requirement of Act 74, Mich. P.A. 1970

For corners in

INGHAM COUNTY (County) Located In: Corner Code #

WHITE OAK TOWNSHIP

1. Public Land Survey T 2N R 2E E 13

2. Property Controlling S T R

in Section S T R

3. Miscellaneous S T R

Property in Sec. S T R

Register of Deeds Stamp & File Number

4. Lot No. , Recorded Plat

5. Private Claims

A	B	C	D	E	F	G	H	I	J	K
2	6	5	4	3	2					
3										
4	7	8	9	10	11					
5										
6	18	17	16	15	14					
7										
8	19	20	21	22	23					
9										
10	30	29	28	27	26					
11										
12	31	32	33	34	35					
13										


I, Dave Clifford, in a field survey on Sep. 3, 1994, do hereby certify that under requirements of P.A. 74, Michigan P.A. of 1970, the corner points mentioned in lines 1 and 2 above were in conformance with regulations and rules therefore as required in the current manual of survey instructions of the United States Department of the Interior, Bureau of Land Management or by a decree of a Court of Law and/or that the corner points mentioned in lines 3, 4 and 5 above were in conformance with the rules of the Michigan Board of Land Surveyors or by a Decree of a Court of Law; established, re-established, monumented, re-monumented, recovered, found as expressed below:

NOTE: Not more than 4 corners, all in the same town and range, may be recorded on this certificate.

- A. Description of original monument and accessories and/or subsequent restoration:
1. Original Post set by J. Wampler D.S. in Aug. 1824
Tam. 5 N58E 17(11.22')
Tam. 6 N43W 38(25.08')
 2. Corner used by A. Jackson Co. Surv. in June 1854 recorded in Vol 2 Page 206 with same mon. & Wit. as in item 1.
 3. Corner Used by W.A. Rowe Co. Surveyor in Oct. 1895 recorded in Field book 15 page 26 in which he stated that he found the old post.

(OVER)

B. Description of corner evidence found and/or method applied in restoring or reestablishing corner:
Searched at apparent location of corner and found 1 1/4" pipe at South base of North-East fence corner post. Excavated all around fence post and found nothing but average fence post stones. Measured West 195.36 feet (the exact GLO falling) to E-1 Stockbridge Township (a 1 1/4" pipe at the North end of a fence to the South). Accepted Pipe as perpetuation of corner because of its relationship to occupation and closing corner and capped with PA345 cap.

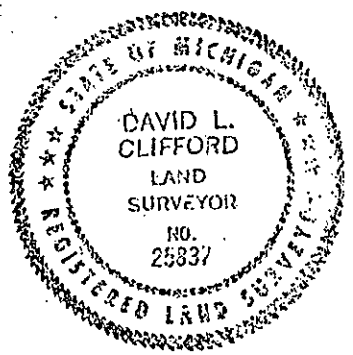

C. Description of monument for corner and accessories established to perpetuate locating the position of the corner:
1 1/4" Iron Pipe and PA 345 Cap PS #25837 at South base of Anchor Post at East-North Fence Corner

Set Nail & Tag#25837 in N. Side 8" Maple Naz 240° 31.55'
Set Nail & Tag#25837 in W. Side 18" Trip. Maple Naz 170° 32.15'
Set Nail & Tag#25837 in N. Side 18" Maple Naz 100° 31.90'
1 1/4" Pipe & PA 345 Cap PS 25837(E-1, T1N,R2E) Naz 270° 195.36'

Signed by Dave Clifford Date Oct 11, 1994

Surveyor's Michigan License No. 25837

A. (Continued from front side)

4. This Surveyor recorded corner in Liber 7 page 39 in Nov. 1988 during the Super Collider project as a 1 $\frac{1}{4}$ " pipe set at base of Anchor post of East-North fence.

24" Maple East 17.55'

Triple 15" Maple S10E 32.45'

24" Maple N70W 28.90'

1 $\frac{1}{4}$ " Iron Pipe (E-1, T1N, R2E) West 195.36'

2746