

SURVEY &  
 REMONUMENTATION  
 APR 10 1995  
 COMMISSION

Dec 1 8 06 AM '94

REGISTER OF DEEDS  
*Frank Johnson*  
 INGHAM COUNTY, MICH.

**LAND CORNER RECORDATION CERTIFICATE**  
 Filing Requirement of Act 74, Mich. P.A. 1970

For corners in

<u>INGHAM COUNTY</u> (County)	Located In:	Corner Code #
White Oak Township		
1. Public Land Survey	T <u>2N</u> R <u>2E</u>	<u>G-13</u>
	T _____ R _____	_____
	T _____ R _____	_____
	T _____ R _____	_____
2. Property Controlling in Section	S _____ T _____ R _____	_____
	S _____ T _____ R _____	_____
3. Miscellaneous Property in Sec.	S _____ T _____ R _____	_____
	S _____ T _____ R _____	_____

Register of Deeds Stamp & File Number

4. Lot No. \_\_\_\_\_, Recorded Plat \_\_\_\_\_  
 5. Private Claims \_\_\_\_\_

A	B	C	D	E	F	G	H	I	J	K	L
2	6	5	4	3	2						
3											
4	7	8	9	10	11	12					
5											
6	18	17	16	15	14	13					
7											
8	19	20	21	22	23	24					
9											
10	30	29	28	27	26	25	24				
11											
12	31	32	33	34	35	36					
13											

I, Dave Clifford, in a field survey on Sep 3, 19 94, do hereby certify that under requirements of P.A. 74, Michigan P.A. of 1970, the corner points mentioned in lines 1 and 2 above were in conformance with regulations and rules therefore as required in the current manual of survey instructions of the United States Department of the Interior, Bureau of Land Management or by a decree of a Court of Law and/or that the corner points mentioned in lines 3, 4 and 5 above were in conformance with the rules of the Michigan Board of Land Surveyors or by a Decree of a Court of Law; established, re-established, monumented, re-monumented, recovered, found as expressed below:

NOTE: Not more than 4 corners, all in the same town and range, may be recorded on this certificate.


A. Description of original monument and accessories and/or subsequent restoration:

1. Original Post set by J. Wampler D.S. in Aug. 1824  
 Tam. 9 N70E 103(67.98')  
 Tam. 15 N40W 228(150.48')
2. In a marginal note, to a survey by T.J. Brown Co. Surveyor recorded in Vol 2, page 251 in Jan 1851, W.A. Rowe Co. Surveyor proved G-1 Stockbridge Township by using G-13 White Oak Township which he found the post and the witnesses of in Oct. 1895.

(OVER)

B. Description of corner evidence found and/or method applied in restoring or reestablishing corner:

Searched at apparent location of corner and found 3/4" pipe on South bank of East-West ditch and 20' East of North-South ditch. Dug all around area and found no other evidence of corner. Accepted pipe as Corner and capped with PA 345 cap.

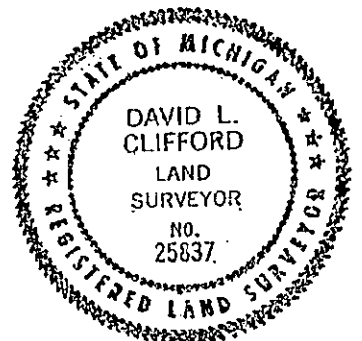

C. Description of monument for corner and accessories established to perpetuate locating the position of the corner:

3/4" Iron Pipe and PA 345 Cap PS #25837, 5' South of centerline East-West ditch and 20' East of North-South ditch.

- Set Nail & Tag#25837 in E. Side 18" Maple Stump Naz 225° 12.30'
- Set Nail & Tag#25837 in W. Side 12" Mult. Maple Naz 168° 6.15'
- Set Nail & Tag#25837 in S. Side 18" Maple Naz 90° 34.65'
- Set Nail & Tag#25837 in N. side 8" Mult. Maple Naz. 134° 35.25'
- 3/4" pipe & PA 345 Cap PS 25837(G-1, T1N, R2E) Naz 268° 114.81'

Signed by Dave Clifford Date Oct 11, 1994

Surveyor's Michigan License No. 25837

2747 P.A. 345 INGHAM COUNTY DEED APPROVED 10/12/94

3. F.K. Holmes LS 14094 set a 3/4" iron pipe in the North post of a fence from the South for G-1 Stockbridge township for MDSH&T in Sep. 1965.
4. This surveyor found anchor post used by Holmes for G-1 Stockbridge while working on the Super Collider Project in Aug. 1988 and using it for direction set G-1 6.65 feet North of it on the Township line. This Surveyor then set a 3/4" pipe at G-13 White Oak at the GLO falling (114.81') East on the Township line.
6. Ron Enger LS 28409 Recorded Corner in Liber 7 of Corners page 76 in Jan 1989 during the Super Collider Project as a 3/4" pipe.  
3/4" pipe (G-1, T1N, R2E) West 114.84'  
Nail & Cap #25837 in 14" Maple S10°W 12.30"  
Nail & Cap #25837 in 18" Twin Maple S5°E 6.20"  
Nail & Cap #25837 in 36" Maple S50°E 53.4'
7. In clarification of method used to establish position of corner in 1988 this surveyor and Ron Enger PS #28409 elected to use F.K. Holmes monument on line monument at the closing corner G-1, T1N, R2E, for direction only (In accordance with proper survey procedure) to establish the true position of G-1 on the township line of T2N, R2E, which falls 6.65' North of the anchor post found by Holmes. The position of G-13, T2N, R2E was then established by setting it at the GLO falling of 114.81'.

2747