

**SURVEY & REMONUMENTATION**

DEC 09 1999

Paula Johnson  
INGHAM COUNTY  
REGISTER OF DEEDS RECORDED  
ENGER SURVEYING & ENGINEERS

L-9 P-490

CRNR 9.00

1999-050552

**LAND CORNER RECORDATION CERTIFICATE**  
Filing Requirement of Act 74, Mich. P.A. 1970

For corners in SECTION

INGHAM COUNTY  
(County)

Located In: Corner Code #

WHITE OAK TOWNSHIP

1. Public Land Survey

T 2N R 2E K-2

T \_\_\_ R \_\_\_

T \_\_\_ R \_\_\_

T \_\_\_ R \_\_\_

2. Property Controlling in Section

S \_\_\_ T \_\_\_ R \_\_\_

S \_\_\_ T \_\_\_ R \_\_\_

3. Miscellaneous Property in Sec.

S \_\_\_ T \_\_\_ R \_\_\_



1999-050552

Page: 1 of 1

10/08/1999 02:29P

Register of Deeds Stamp & File Number

4. Lot No. \_\_\_\_\_, Recorded Plat \_\_\_\_\_  
5. Private Claims \_\_\_\_\_

I, DAVID L. CLIFFORD, in a field survey on AUG. 6, 1999 Do hereby state that under requirements of P.A. 74, Michigan P.A. of 1970, the corner points mentioned in lines 1 and 2 above were in conformance with regulations and rules therefore as required in the current manual of survey instructions of the United States Department of the Interior, Bureau of Land Management or by a decree of a Court of Law and /or that the corner points mentioned in lines 3, 4 and 5 above were in conformance with the rules of the Michigan Board of Land Surveyors or by a Decree of a Court of Law, established, re-established, monumented, recovered, found as expressed below:

**NOTE: Not more than 2 corners, all in the same town and range, may be recorded on this certificate.**

	A	B	C	D	E	F	G	H	I	J	K	L	N
1													
2	6		5		4		3		2		1		
3													
4	7		8		9		10		11		12		
5													
6	18		17		16		15		14		13		
7													
8	19		20		21		22		23		24		
9													
10	30		29		28		27		26		25		
11													
12	31		32		33		34		35		36		
13													

A. Description of original monument and accessories and/or subsequent restoration:

1. POST SET IN ORIGINAL GOVERNMENT SURVEY BY J. WAMPLER, D.S., IN NOV. 1825; MAPLE -, S80½W, 1½ LKS; W.O. 22, S78E, 9 LKS.

2. TJ BROWN, COUNTY SURVEYOR USED CORNER IN A SURVEY RECORDED IN VOLUME 2 PAGE 356 IN FEB. 1859 IN THE INGHAM COUNTY SURVEYOR RECORDS WITH NO MENTION OF MONUMENT OR WITNESSES

3. GARY BOSS RLS #17022 USED CORNER IN ACT 132 SURVEYS RECORDED IN LIBER 3 PAGE 222 IN DEC. 1977 AND LIBER 5 PAGE 366 IN DEC. 1987 AND RECORDED CORNER IN LIBER 5 PAGE 176 IN JAN. 1979 AS A SET 1/2" IRON AT A FENCE CORNER; SPIKE IN S/S FENCE POST, EAST, 17.30'; SPIKE IN E/S 14" HICK., NORTH, 97.79'; SPIKE IN S/S 14" HICK., WEST, 7.42'; SPIKE IN E/S 12" HICK., SOUTH 12.40'.

4. M. MAHIEU LPS #28414 USED CORNER IN ACT 132 SURVEYS RECORDED IN LIBER 7 PAGES 612, 622 AND 623 IN JUNE 1995 AS A FOUND 1/2" BAR WITH "BOSS" CAP: N&T 28414, E. SIDE 20" HICKORY, SOUTH, 12.81'; N&T 28414, S. SIDE WOOD POST, EAST, 17.70'; N&T 28414, N. SIDE 15" HICKORY, S80°W, 7.35'; N&T 28414, E. SIDE 32" HICKORY, NORTH, 97.17';


B. Description of corner evidence found and/or method applied in restoring or reestablishing corner:

SEARCHED AT APPARENT LOCATION OF CORNER AND FOUND 1/2" BAR IN CENTER OF CONCRETE BASE OF RUSTED OFF 4" STEEL FENCE POST MATCHING 3 OF BOSS'S WITNESSES AND 3 OF MAHIEU'S WITNESSES (THE HICKORY TO THE NORTH BEING RECENTLY BLOWN OVER). EXCAVATED 4" DIAMETER HOLE AROUND CONCRETE BASE AND FOUND LARGE AMOUNT OF FIELD STONE (AS YOU WOULD EXPECT TO FIND AROUND ANY FENCE CORNER). TRAVERSE OF SECTION REVEALED THAT CORNER WAS WITHIN 1.5 FEET OF A PRORATION OF THE GLO LOCATION AND WITHIN 0.16 FEET OF A STRAIGHT LINE BETWEEN SECTION CORNERS. MEASURED NORTH 3342.46' TO K-1. MEASURED EAST 2639.05' TO L-2. MEASURED SOUTH 2659.30' TO K-3. ACCEPTED IRON AS PERPETUATION OF CORNER AND DROVE STANDARD BAR IN ON TOP OF IT.

C. Description of monument for corner and accessories established to perpetuate locating the position of the corner:

K-2 T2N-R2E  
3/4" X 24 SMOOTH STEEL BAR WITH 2 1/4" ALUMINUM CAP STAMPED PA 345 25837 INGHAM COUNTY

FOUND NAIL & TAG 28414, NORTH SIDE 18" TWIN HICKORY, S85°W, 7.45'  
FOUND NAIL & TAG 28414, EAST SIDE 19" HICKORY, S07°W, 12.95'  
FOUND NAIL & TAG 28414, SOUTH SIDE GATE POST, S85°E, 17.55'  
SET NAIL & TAG 28409 (RON ENGER), EAST SIDE 18" OAK, S18°E, 137.05'

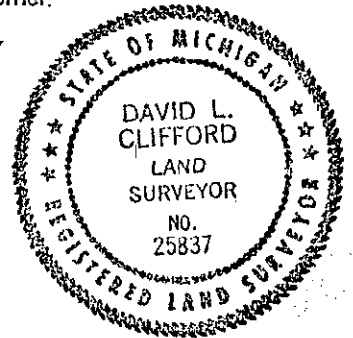

Signed by David Clifford  
Surveyor's Michigan License No. 25837

Date JULY 07, 1999

FORM APPROVED BY MICHIGAN STATE BOARD OF PROFESSIONAL SURVEYORS, JAN 28, 1971  
REVISED MAY 14, 1976  
REVISED JAN, 1983  
REVISED OCT, 1995

P.A. 345 INGHAM COUNTY  
PEER APPROVED 8/17/99 RL