

**SURVEY & REMONUMENTATION**

DEC 09 1999

Paula Johnson  
INGHAM COUNTY  
REGISTER OF DEEDS  
ENGINEER SURVEYING & ENGINEERING

L-9 P-492

RECORDED  
CRNR 9.00

1999-050554

**SECTION**

**LAND CORNER RECORDATION CERTIFICATE**  
Filing Requirement of Act 74, Mich. P.A. 1970

For corners in

INGHAM COUNTY (County)	Located in:	Corner Code #
WHITE OAK TOWNSHIP	T 2N R 2E	K-4
1. Public Land Survey	T ___ R ___	_____
	T ___ R ___	_____
	T ___ R ___	_____
2. Property Controlling in Section	S ___ T ___ R ___	_____
	S ___ T ___ R ___	_____
3. Miscellaneous Property in Sec.	S ___ T ___ R ___	_____



1999-050554  
Page: 1 of 1  
10/08/1999 02:29P

Register of Deeds Stamp & File Number

4. Lot No. \_\_\_\_\_, Recorded Plat \_\_\_\_\_  
5. Private Claims \_\_\_\_\_

I, DAVID L. CLIFFORD, in a field survey on AUG. 30, 1999 Do hereby state that under requirements of P.A. 74, Michigan P.A. of 1970, the corner points mentioned in lines 1 and 2 above were in conformance with regulations and rules therefore as required in the current manual of survey instructions of the United States Department of the Interior, Bureau of Land Management or by a decree of a Court of Law and /or that the corner points mentioned in lines 3, 4 and 5 above were in conformance with the rules of the Michigan Board of Land Surveyors or by a Decree of a Court of Law, established, re-established, monumented, recovered, found as expressed below:

**NOTE: Not more than 2 corners, all in the same town and range, may be recorded on this certificate.**

	A	B	C	D	E	F	G	H	I	J	K	L	M
1													
2	6			5			4			3		2	1
3													
4	7			8			9			10		11	12
5													
6	18			17			16			15		14	13
7													
8	19			20			21			22		23	24
9													
10	30			29			28			27		26	25
11													
12	31			32			33			34		35	36
13													

**A. Description of original monument and accessories and/or subsequent restoration:**


- POST SET IN ORIGINAL GOVERNMENT SURVEY BY J. WAMPLER, D.S., IN NOV. 1825; ASH 18, S51½E, 311 LKS; NO OTHER
- A. JACKSON, COUNTY SURVEYOR USED CORNER IN A SURVEY RECORDED IN VOLUME 1 PAGE 145 IN NOV. 1838 IN THE INGHAM COUNTY SURVEYOR RECORDS WITH NO MENTION OF MONUMENT AND THE GLO WITNESS.
- TJ BROWN, COUNTY SURVEYOR USED CORNER IN A SURVEY RECORDED IN VOLUME 2 PAGE 355 IN FEB. 1859 IN THE INGHAM COUNTY SURVEYOR RECORDS WITH NO MENTION OF MONUMENT AND THE GLO WITNESS.
- PAT BENTON RLS #19826 RECORDED CORNER IN LIBER 4 PAGE 391 IN JULY 1978 AS A SET IRON; N15E, 15.5', FENCE POST.
- M. DYER RLS #21565 USED CORNER IN AN ACT 132 SURVEY RECORDED IN LIBER 2 PAGE 682 IN JANUARY 1976 WITH THE SAME MONUMENT AND WITNESS AS ITEM #4 ABOVE.
- M. MAHIEU LLS #28414 RECORDED CORNER IN LIBER 2 PAGE 274 IN JUNE 1992 AS A FOUND 1/2" IRON WITH CAP #19826: NAIL & TAG #28414 S. SIDE 12" ELM, N60°W, 33.65'; NAIL & TAG #28414 S. SIDE 42" POPLAR, N45°W, 51.87'; NAIL & TAG #28414 W. SIDE 6" OAK, N10°W, 44.18'; & TAG #28414 S. SIDE 15" POPLAR, N70°W, 46.02'.

**B. Description of corner evidence found and/or method applied in restoring or reestablishing corner:**

SEARCHED AT APPARENT LOCATION OF CORNER AND FOUND 1/2" BAR & CAP #19826 BETWEEN 2 DITCHES FROM NORTH & WEST ON THE NORTH BANK OF THE MCMAHAN DRAIN ON EXTENDED FENCE LINES FROM THE NORTH, SOUTH, EAST & WEST. TRAVERSE OF SECTION SHOWS IRON TO BE VERY CLOSE TO HALF WAY AND ON LINE BETWEEN THE SECTION CORNERS. ACCEPTED 1/2" BAR & CAP AS PERPETUATION OF CORNER AND REPLACED IT WITH 5/8" REBAR AND ALUMINUM CAP. MEASURED NORTH 2659.22' TO K-3. MEASURED EAST 2670.63' TO L-4. MEASURED SOUTH 2657.30' TO K-5.

**C. Description of monument for corner and accessories established to perpetuate locating the position of the corner:**

K-4 T2N-R2E  
5/8" X 24" REBAR WITH 2 1/4" ALUMINUM CAP STAMPED PA 345 25837 INGHAM COUNTY  
SET NAIL & TAG 28409 (RON ENGER), SOUTH SIDE 5" WILLOW, N88°E, 13.2'  
SET NAIL & TAG 28409, WEST SIDE 5" TWIN WALNUT, N10°E, 57.6'  
SET NAIL & TAG 28409, SE SIDE 7" OAK, N10°W, 44.1'  
SET NAIL & TAG 28409, SOUTH SIDE 40" TWIN COTTONWOOD, N57°W, 36.6'

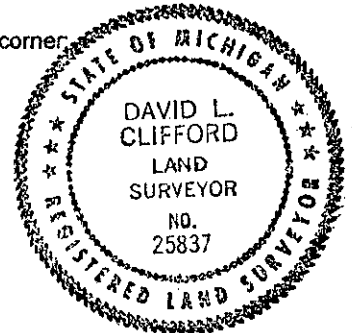

Signed by David Clifford  
Surveyor's Michigan License No. 25837

Date SEPTEMBER 03, 1999

P.A. 345 INGHAM COUNTY  
PEER APPROVED 9/21/99 ML