

SURVEY & REMONUMENTATION

DEC 09 1999

SECTION

LAND CORNER RECORDATION CERTIFICATE
Filing Requirement of Act 74, Mich. P.A. 1970

For corners in

INGHAM COUNTY Located in: Corner Code #

(County) WHITE OAK TOWNSHIP

1. Public Land Survey T 2N R 2E K-6

T _____ R _____

T _____ R _____

T _____ R _____

2. Property Controlling S _____ T _____ R _____

in Section S _____ T _____ R _____

3. Miscellaneous _____ T _____ R _____

Property in Sec. S _____ T _____ R _____

4. Lot No. _____, Recorded Plat _____

5. Private Claims _____

Paula Johnson
INGHAM COUNTY
REGISTER OF DEEDS RECORDED
ENGINEER SURVEYING & ENGINEER CRNR 9.00

L-9 P-549

1999-060039



1999-060039
Page: 1 of 1
11/30/1999 09:48A

Register of Deeds Stamp & File Number

	A	B	C	D	E	F	G	H	I	J	K	L	M
1													
2	6		5		4		3		2		1		
3													
4	7		8		9		10		11		12		
5													
6	18		17		16		15		14	13			
7													
8	19		20		21		22		23		24		
9													
10	30		29		28		27		26		25		
11													
12	31		32		33		34		35		36		
13													

I, DAVID L. CLIFFORD, in a field survey on AUG. 26, 1999 Do hereby state that under requirements of P.A. 74, Michigan P.A. of 1970, the corner points mentioned in lines 1 and 2 above were in conformance with regulations and rules therefore as required in the current manual of survey instructions of the United States Department of the Interior, Bureau of Land Management or by a decree of a Court of Law and /or that the corner points mentioned in lines 3, 4 and 5 above were in conformance with the rules of the Michigan Board of Land Surveyors or by a Decree of a Court of Law; established, re-established, monumented, recovered, found as expressed below.

NOTE: Not more than 2 corners, all in the same town and range, may be recorded on this certificate.

A. Description of original monument and accessories and/or subsequent restoration:


1. POST SET IN ORIGINAL GOVERNMENT SURVEY BY J. WAMPLER, D.S., IN NOV. 1825; MAPLE 5, S10E, 32 LKS; BO 22, N65 1/2 W, 32 LKS.
2. TJ BROWN, DEPUTY COUNTY SURVEYOR USED CORNER IN A SURVEY RECORDED IN VOLUME 3 PAGE 45 IN JUNE 1870 IN THE INGHAM COUNTY SURVEYOR RECORDS AS A STONE SET FOR CORNER.
3. E.A. CALKINS, COUNTY SURVEYOR, USED CORNER IN A SURVEY RECORDED IN VOLUME 5 PAGE 19 IN MAY 1901 AS "OLD STONE": HICK. 10", S42°E, 58 LKS (38.3'); W. OAK 10", S58°W, 49-1/3 LKS. (32.6'). CALKINS ALSO SET A WELL POINT AT THE 1/8 CORNER TO THE SOUTH AND A BUGGY AXLE AT K-7.
4. O. BOSS RLS #13574 RECORDED CORNER IN LIBER 3 PAGE 531 IN FEB. 1976 AND USED IT IN AN ACT 132 SURVEY RECORDED IN LIBER 1 PAGES 1223-1226 IN JUNE 1976 AS A FOUND 1/2" IRON: SPIKE NW SIDE 24" OAK, S59°W, 31.02'; SPIKE N. SIDE 22" OAK, N71°W, 21.07'; SPIKE SW SIDE 18" HICKORY, S43°E, 42.61'.
5. K. PIOTROWSKI RLS #9685 RECORDED CORNER IN LIBER 4 PAGE 72 IN JUNE 1977 AND USED CORNER IN AN ACT 132 SURVEY RECORDED IN LIBER 2 PAGE 390 IN OCT. 1975 AS A FOUND 1/2" RE-ROD: N85°W, 20.8', 24" OAK; S45°E, 42.43', 20" HICKORY; S60°W, 30.7', 24" OAK.
6. G. BOSS RLS #17022 USED CORNER IN AN ACT 132 SURVEY RECORDED IN LIBER 61 PAGE 263 & 264 IN JUNE 1990 WITH SAME MONUMENT AND WITNESSES AS ITEM 4 ABOVE.
7. M. MAHIEU LPS #28414 USED CORNER AN ACT 132 SURVEY RECORDED IN LIBER 8 PAGE 328 IN NOV. 1998 AS A 1/2" BAR: N&T #29238 W. SIDE 28" HICKORY, S13°E, 41.58'; NAIL S. SIDE 36" OAK, N80°W, 20.50'; N&T #28414 E. SIDE 5" MAPLE, S15°W, 38.20'; N&T #28414 S. SIDE 36" OAK, N80°W, 20.50'; N&T #28414 SE SIDE 10" HICKORY, N40°E, 41.55'.

B. Description of corner evidence found and/or method applied in restoring or reestablishing corner:

SEARCHED AT APPARENT LOCATION OF CORNER AND FOUND 1/2" BAR MATCHING ALL MODERN DAY WITNESSES ABOVE BUT NOT MATCHING CALKINS WITNESSES OF 1901 (THE HICKORY IS STILL STANDING AND THE OAK IS A STUMP). EXCAVATED 2' DIAMETER HOLE 2' DEEP INTO NATURAL GROUND AT INTERSECTION OF CALKINS WITNESSES. DID NOT FIND STONE PROBABLY BECAUSE IT WAS DESTROYED IN A ROAD CUT OF ABOUT 3.5'. RECOVERED CALKINS WELL POINT AT THE NEXT 1/8 CORNER SOUTH AND THE 1" REBAR THAT THE ROAD COMMISSION SET IN PLACE OF CALKINS BUGGY AXLE AT K-7. MEASURED 1334.14' FROM K-7 TO WELL POINT. EXTENDED LINE FROM K-7 THROUGH WELL POINT 1334.14' NORTH AND SET CORNER. EXCAVATED 2' DIAMETER HOLE 2' DEEP INTO NATURAL GROUND AND FOUND NO FURTHER EVIDENCE OF CORNER LOCATION. THIS LOCATION IS ABOUT 1.5' NW OF INTERSECTION OF CALKINS WITNESSES AND THE EXCAVATIONS OVERLAPPED. EXCEPTED THIS LOCATION AS THE LOCATION OF CORNER AS PERPETUATED BY CALKINS AND SET 5/8" REBAR WITH 2 1/4" ALUMINUM CAP AND MONUMENT BOX. AT THE DIRECTION OF THE PEER REVIEW GROUP RETURNED TO CORNER ON OCTOBER 26, 1999 AND MOVED CORNER MONUMENT & MONUMENT BOX TO RECORDED LOCATION OF CORNER. ACCEPTED THIS LOCATION AS PERPETUATED LOCATION OF CORNER. MEASURED NORTH 2666.15' TO K-5. MEASURED SOUTH 2668.80' TO K-7.

C. Description of monument for corner and accessories established to perpetuate locating the position of the corner:

K-6 T2N-R2E
5/8" X 24" REBAR WITH 2 1/4" ALUMINUM CAP STAMPED PA 345 25837 INGHAM COUNTY
FOUND NAIL & TAG 28414, EAST SIDE 7" HICKORY, N35°E, 41.50'
FOUND BOSS ENGINEERING NAIL & TAG, WEST SIDE 21" HICKORY, S40°E, 41.50'
FOUND NAIL & TAG 28414, EAST SIDE 4" MAPLE, S40°W, 38.23'
FOUND NAIL & TAG 28414, SOUTH SIDE 35" OAK, N70°W, 20.50'

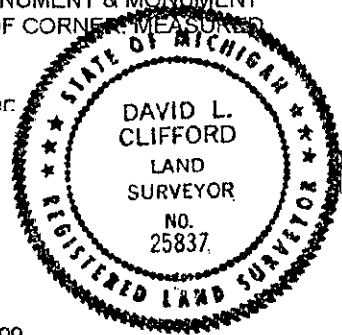

Signed by David L. Clifford
Surveyor's Michigan License No. 25837

Date OCTOBER 27, 1999