

DEC 17 1998

SECTION

LAND CORNER RECORDATION CERTIFICATE  
Filing Requirement of Act 74, Mich. P.A. 1970

Liber 9 Page 420

For corners in

<u>INGHAM COUNTY</u>	Located In:	Corner Code #
(County)		
WHITE OAK TOWNSHIP		
1. Public Land Survey	<u>T 2N R 2E</u>	<u>K-11</u>
	T ___ R ___	_____
	T ___ R ___	_____
	T ___ R ___	_____
2. Property Controlling in Section	S ___ T ___ R ___	_____
	S ___ T ___ R ___	_____
3. Miscellaneous Property in Sec.	S ___ T ___ R ___	_____
	S ___ T ___ R ___	_____

FILED

980060996  
12/01/1998 09:36:08  
REGISTER OF DEEDS  
Paula Johnson  
INGHAM COUNTY, MI

Register of Deeds Stamp & File Number

4. Lot No. \_\_\_\_\_, Recorded Plat \_\_\_\_\_  
5. Private Claims \_\_\_\_\_

I, DAVID L. CLIFFORD, in a field survey on OCTOBER 31, 1998. Do hereby state that under requirements of P.A. 74, Michigan P.A. of 1970, the corner points mentioned in lines 1 and 2 above were in conformance with regulations and rules therefore as required in the current manual of survey instructions of the United States Department of the Interior, Bureau of Land Management or by a decree of a Court of Law and for that the corner points mentioned in lines 3, 4 and 5 above were in conformance with the rules of the Michigan Board of Land Surveyors or by a Decree of a Court of Law; established, re-established, monumented, recovered, found as expressed below.

NOTE: Not more than 2 corners, all in the same town and range, may be recorded on this certificate.

A	B	C	D	E	F	G	H	I	J	K	L	M
1												
2	6	5	4	3	2	1						
3												
4	7	8	9	10	11	12						
5												
6	18	17	16	15	14	13						
7												
8	19	20	21	22	23	24						
9												
10	30	29	28	27	26	25						
11									0			
12	31	32	33	34	35	36						
13												

A. Description of original monument and accessories and/or subsequent restoration:


- JOSEPH WAMPLER D.S. SET POST IN ORIGINAL GOVERNMENT SURVEY IN NOVEMBER 1825 W.O. 14" S77E 157 LKS; W.O. 13" N42 1/2 E 150 LKS;
- TJ BROWN, COUNTY SURVEYOR, USED CORNER IN A SURVEY RECORDED IN THE INGHAM COUNTY SURVEYOR RECORDS IN VOLUME 2 PAGE 329 IN JAN. 1858 WITH NO MENTION OF MONUMENT OR WITNESSES, BROWN USED CORNER AGAIN IN A SURVEY RECORDED IN VOLUME 2 PAGE 330 IN MARCH 1858 WITH SAME WITNESSES AS GLO. BROWN USED CORNER AGAIN IN A SURVEY RECORDED IN VOLUME 2 PAGE 365 IN JAN. 1860; R.O. 7" N42-3/4E 81-3/4 LKS, DBL R.O., 6" S64-1/4E, 162 LKS; BROWN MEASURED EAST 2650.56 TO L-11.
- W.H. RAYNER, COUNTY SURVEYOR, USED CORNER IN A SURVEY RECORDED IN VOLUME 3 PAGE 89 IN OCT. 1867 WITH SAME WITNESSES AS BROWNS 1860 WITNESSES.
- GEORGE YOUNG RLS # 17640 RECORDED CORNER IN LIBER 4 OF CORNERS PAGE 97 IN SEP. 1977 AND USED IT IN SURVEYS RECORDED IN LIBER 1 OF SURVEYS PAGE 535 IN DEC. 1972 AND IN LIBER 3 OF SURVEYS PAGE 28 IN APRIL 1977 AS A SET 1/2" BAR & CAP BY DOUBLE PROPORTIONATE MEASUREMENT; #16 NAIL & CAP IN 15" ASH, N75°E, 106.42'; #16 NAIL & CAP IN 6" ELM, S45°W, 18.92'; RR SPIKE IN 36" OAK, S50°E, 142.28'.
- THIS SURVEYOR TRAVERSED TO AND WITNESSED CORNER WHILE WORKING ON THE SUPER COLLIDER PROJECT IN AUGUST 1988: 1/2" BAR & CAP; N&T 25837 IN MAIL BOX POST, NE, 27.74'; N&T 25837 IN DBL. OAK, S70°E, 108.65'; N&T 25837 IN 40" OAK, S50°E 141.30'
- MAURICE MAHIEU RLS #28414 USED CORNER IN SURVEYS RECORDED IN LIBER 5 OF SURVEYS PAGES 1229 AND 1231 IN NOVEMBER 1989 AS A FOUND 1/2" IRON ROD; NAIL & TAG #25837 IN N. FACE (2) 28" OAK, S87°E, 108.69'; NAIL & TAG #17640 IN W. FACE 12" ELM, S5°W, 128.22'; NAIL & TAG #17640 IN N. FACE 48" OAK, S50°E, 141.17'; NAIL & TAG #25837 IN S. FACE MAIL BOX POST, N70°W, 27.60'

B. Description of corner evidence found and/or method applied in restoring or reestablishing corner:

SEARCHED AT APPARENT LOCATION OF CORNER AND FOUND A 1/2" REBAR 5.5' WEST OF CENTERLINE BROGAN ROAD AT ABANDONED GILLIAM ROAD TO THE EAST. YOUNGS OAK WITNESS TO THE SE STILL STANDS AND 3 OF MAHIEU'S WITNESSES STILL STAND AND MATCH LOCATION OF BAR. (THE MAIL BOX POST WITNESS HAS BEEN MOVED). AS THIS IS A FILL SECTION OVER SWAMP DID NOT EXCAVATE BECAUSE CHANCE OF FINDING ANYTHING OF A HISTORICAL NATURE IS NIL. ACCEPTED BAR AS PERPETUATION OF CORNER AND REPLACED IT WITH A STANDARD MONUMENT. MEASURED SOUTH 2659.75' TO K-12 AND EAST 2656.55 TO L-11. MEASURED WEST 2701.7 TO J-11 DURING SUPER COLLIDER PROJECT.

C. Description of monument for corner and accessories established to perpetuate locating the position of the corner:

K-11 T2N-R2E  
3/4" BAR & 2 1/2" ALUMINUM CAP STAMPED PA 345 LS 25837 INGHAM COUNTY IN MONUMENT BOX FOUND NAIL & TAG 25837, S. SIDE MAIL BOX POST, N72°E, 26.10'  
SET NAIL & TAG 28409, N. SIDE 20" TWIN OAK, S77°E, 110.22'  
R.R. SPIKE E. SIDE UTILITY POLE, N20°E, 104.10'  
SET NAIL & TAG #28409, SE SIDE 48" OAK, S57°E, 143.17'  
SET NAIL & TAG #28409 IN E. SIDE UTILITY POLE, N10°W, 95.25'

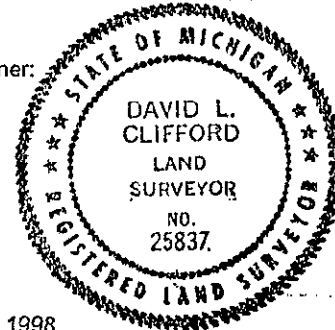

Signed by David Clifford

Date NOVEMBER 03, 1998

Surveyor's Michigan License No. 25837