

DEC 17 1998

SECTION

LAND CORNER RECORDATION CERTIFICATE  
Filing Requirement of Act 74, Mich. P.A. 1970

Liber 9 Page 421

For corners in

<u>INGHAM COUNTY</u> (County)	Located In:	Corner Code #
WHITE OAK TOWNSHIP	T <u>2N</u> R <u>2E</u>	<u>K-12</u>
1. Public Land Survey	T ___ R ___	_____
	T ___ R ___	_____
	T ___ R ___	_____
2. Property Controlling in Section	S ___ T ___ R ___	_____
	S ___ T ___ R ___	_____
3. Miscellaneous Property in Sec.	S ___ T ___ R ___	_____
	S ___ T ___ R ___	_____
4. Lot No. _____, Recorded Plat _____		
5. Private Claims _____		

**FILED**  
980060997  
12/01/1998 09:36:09  
REGISTER OF DEEDS  
Paula Johnson  
INGHAM COUNTY, MI

Register of Deeds Stamp & File Number

I, DAVID L. CLIFFORD, in a field survey on SEP. 1, 1998 Do hereby state that under requirements of P.A. 74, Michigan P.A. of 1970, the corner points mentioned in lines 1 and 2 above were in conformance with regulations and rules therefore as required in the current manual of survey instructions of the United States Department of the Interior, Bureau of Land Management or by a decree of a Court of Law and /or that the corner points mentioned in lines 3, 4 and 5 above were in conformance with the rules of the Michigan Board of Land Surveyors or by a Decree of a Court of Law; established, re-established, monumented, recovered, found as expressed below:

NOTE: Not more than 2 corners, all in the same town and range, may be recorded on this certificate.


A	B	C	D	E	F	G	H	I	J	K	L	M
1												
2	6		5		4		3		2		1	
3												
4	7		8		9		10		11		12	
5												
6	18		17		16		15		14		13	
7												
8	19		20		21		22		23		24	
9												
10	30		29		28		27		26		25	
11												
12	31		32		33		34		35		36	
13												

A. Description of original monument and accessories and/or subsequent restoration:

- JOSEPH WAMPLER D.S. SET POST IN ORIGINAL GOVERNMENT SURVEY IN NOVEMBER 1825 W.O. 18" S15E 22 LKS; W.O. 22" N61W 16 1/2 LKS;
- FG SEE, DEPUTY COUNTY SURVEYOR, USED CORNER IN SURVEYS RECORDED IN VOLUME 1 PAGE 156 & 157 IN OCT. 1844 WITH SAME MONUMENT AND WITNESSES AS GLO;
- TJ BROWN, COUNTY SURVEYOR, USED CORNER IN SURVEYS RECORDED IN THE INGHAM COUNTY SURVEYOR RECORDS IN VOLUME 2 PAGE 329 IN JAN. 1858, VOLUME 2 PAGE 365 IN JAN. 1860 AND VOLUME 3 PAGE 89 IN DEC. 1874; POST, W.O. 12' S83 1/2 E 266 LKS; W.O. 16" N70W 172 LKS.
- WA ROWE, COUNTY SURVEYOR, USED CORNER IN A SURVEY RECORDED IN VOLUME 5 PAGE 5 IN THE INGHAM COUNTY SURVEYOR RECORDS IN DEC. 1899, STONE AND BRICK, OLD POST FOUND; W. OAK 30" S83 1/2 E 260 LKS (171.6')
- THE INGHAM ROAD COMMISSION GRID MAP IDENTIFIES CORNER AS BLUE STONE AND BRICK; OAK 18" SE 53.5', OAK 6" WSW 64.3'; USGS MONUMENT SE 43.4'; ROAD SIGN NE 35.4'; ANCH. POST NW 44.7';
- GEORGE YOUNG RLS # 17640 RECORDED CORNER IN LIBER 2 OF CORNERS PAGE 269 IN DEC. 1972 AND USED IT IN SURVEYS RECORDED IN LIBER 1 OF SURVEYS PAGE 535 IN DEC. 1972 AND IN LIBER 3 OF SURVEYS PAGE 28 IN APRIL 1977 AS A SET 1/2" BAR & CAP NEXT TO FOUND STONE; RR SPIKE IN 27" OAK WSW 64.52'; RR SPIKE IN TELEPHONE POLE NE 50.90'; RR SPIKE IN 21" HICKORY SE 53.04'; USGS MONUMENT SE 43.43'
- MAURICE MAHIEU RLS #28414 USED CORNER IN SURVEYS RECORDED IN LIBER 5 OF SURVEYS PAGES 1229 AND 1231 IN NOVEMBER 1989 AS A FOUND 1/2" IRON ROD; NAIL & TAG #25837 IN N. FACE 36" OAK, S80°W, 64.49'; NAIL & TAG #17640 IN SW. FACE 32" HICKORY, S45°E, 52.73'; NAIL & TAG #17640 IN N. FACE 56" OAK, S85°E, 171.51'; NAIL & TAG #17640 IN S. FACE 32" HICKORY, N85°E, 150.00'

B. Description of corner evidence found and/or method applied in restoring or reestablishing corner:  
SEARCHED AT APPARENT LOCATION OF CORNER AND FOUND A 1/2" REBAR IN MONUMENT BOX 3' WEST OF CENTERLINE BROGAN ROAD ON CENTERLINE SWAN ROAD MATCHING ROWE'S LONE WITNESS, 3 OF YOUNG'S WITNESSES, 3 ROAD COMMISSION WITNESSES AND ALL OF MAHIEU'S WITNESSES. REMOVED BAR & MONUMENT BOX AND FOUND BLUE STONE SURROUNDED BY BROKEN BRICK AND CROCKERY UNDER THE WEST EDGE OF MONUMENT BOX. ACCEPTED STONE AS CORNER AS PERPETUATED BY ROWE AND REPLACED 1/2" BAR WITH 3/4" BAR & ALUMINUM CAP AND RESET MONUMENT BOX.

C. Description of monument for corner and accessories established to perpetuate locating the position of the corner:  
K-12 T2N-R2E  
3/4" BAR & 2 1/2" ALUMINUM CAP STAMPED PA 345 LS 25837 INGHAM COUNTY IN MONUMENT BOX  
FOUND NAIL & TAG 25837, N. SIDE 38" OAK, S74°W, 64.45'  
SET NAIL & TAG 28409, W. SIDE 27" OAK, S80°W, 86.55'  
R.R. SPIKE S. SIDE 28" HICKORY, S50°E, 53.00'  
SET NAIL & TAG #25837, N. SIDE 20" OAK, S83°W, 126.29'  
USGS MONUMENT, S45°E, 43.75'  
SET NAIL & TAG #28409 IN S. SIDE 19" HICKORY, N81°E, 149.90'  
FOUND NAIL & TAG #17640 IN N. SIDE 54" OAK, S87°E, 171.50' (ROWE WITNESS)

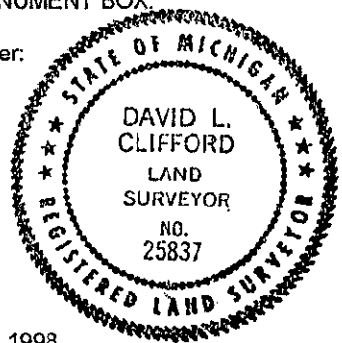

Signed by David Clifford Date SEPTEMBER 19, 1998  
Surveyor's Michigan License No. 25837

P.A. 345 INGHAM COUNTY  
PEER APPROVED: 9/22/98 MC