

DEC 17 1998

SECTION

LAND CORNER RECORDATION CERTIFICATE  
Filing Requirement of Act 74, Mich. P.A. 1970

Liber 9 Page 422

For corners in

INGHAM COUNTY	Located In:	Corner Code #
(County)		
WHITE OAK TOWNSHIP	T <u>2N</u> R <u>2E</u>	<u>K-13</u>
1. Public Land Survey	T _____ R _____	_____
	T _____ R _____	_____
	T _____ R _____	_____
2. Property Controlling in Section	S _____ T _____ R _____	_____
	S _____ T _____ R _____	_____
3. Miscellaneous Property in Sec.	S _____ T _____ R _____	_____
	S _____ T _____ R _____	_____

FILED

980060998  
12/01/1998 09:36:11  
REGISTER OF DEEDS  
Paula Johnson  
INGHAM COUNTY, MI

Register of Deeds Stamp & File Number

4. Lot No. \_\_\_\_\_, Recorded Plat \_\_\_\_\_  
5. Private Claims \_\_\_\_\_

I, DAVID L. CLIFFORD, in a field survey on MAY 22, 1998 Do hereby state that under requirements of P.A. 74, Michigan P.A. of 1970, the corner points mentioned in lines 1 and 2 above were in conformance with regulations and rules therefore as required in the current manual of survey instructions of the United States Department of the Interior, Bureau of Land Management or by a decree of a Court of Law and/or that the corner points mentioned in lines 3, 4 and 5 above were in conformance with the rules of the Michigan Board of Land Surveyors or by a Decree of a Court of Law, established, re-established, monumented, recovered, found as expressed below:

NOTE: Not more than 2 corners, all in the same town and range, may be recorded on this certificate.

A. Description of original monument and accessories and/or subsequent restoration:


1. JOSEPH WAMPLER D.S. SET POST IN ORIGINAL GOVERNMENT SURVEY IN JULY 1824 W.O. 16" N74W 90 LKS; W.O. 16" N49E 182 LKS;
2. JOSEPH WAMPLER D.S. SET POST FOR K-1, T1N R2E IN ORIGINAL GOVERNMENT SURVEY IN NOVEMBER 1825 "INTERSECTED NORTH. BDRY. 119 LKS (78.54') EAST OF POST"; W.O. 18" S33E 52 LKS; B.O. 9" S31W 113 LKS;
3. FG SEE, DEPUTY COUNTY SURVEYOR, USED CORNER IN SURVEYS RECORDED IN VOLUME 1 PAGE 156 & 157 IN OCT. 1844 WITH SAME MONUMENT AND WITNESSES AS GLO;
4. TJ BROWN, COUNTY SURVEYOR, USED CORNER IN A SURVEY RECORDED IN VOLUME 2 PAGE 329 IN JAN. 1858 WITH SAME MONUMENT AND WITNESSES AS GLO;
5. WA ROWE, COUNTY SURVEYOR, IDENTIFIED CORNER AS A TILE AND GAS PIPE SET 119 LKS WEST OF STOCKBRIDGE CORNER IN A SURVEY RECORDED IN VOLUME 5 PAGE 5 IN DEC. 1899, B. WALNUT 12" S1°W 50 LKS, SUG. 12" N54°E 47LKS;
6. W. BERRYMAN, COUNTY SURVEYOR, IDENTIFIED CORNER AS A 1/2" PIPE SET 119 LKS WEST OF NORTHEAST CORNER IN HIS PRIVATE NOTES, DATE UNKNOWN, MAPLE 24" N54°E 31.5', WALNUT 12" S1°W 33.0', NORTHEAST CORNER HOUSE WALL SOUTH 83.5';
7. THIS SURVEYOR EXCAVATED 10' X 10' HOLE 4' DEEP 78.5' WEST OF K-1 T1N R2E IN AUG. 1988 (BOY WAS IT HOT) WHILE WORKING ON THE SUPER CONDUCTING SUPER COLLIDER. NO MONUMENTATION WAS FOUND AND A 1/2" BAR & CAP WAS SET ON THE STANDARD LINE 78.54' WEST OF K-1 STOCKBRIDGE. ROWE AND BERRYMAN'S MAPLE WITNESS AND BERRYMAN'S HOUSE WITNESS WERE STILL STANDING AND FIT LOCATION OF CORNER EXACTLY.

B. Description of corner evidence found and/or method applied in restoring or reestablishing corner:

SEARCHED AT APPARENT LOCATION OF CORNER AND FOUND A 1/2" REBAR & CAP #25837 IN TOP OF SOUTH BANK OF NORTH DITCH OF HIGHWAY M-36. BERRYMAN'S 2 WITNESSES STILL STAND AND ALL OF MY WITNESSES OF 1988 STILL STAND. ACCEPTED MONUMENT AS PERPETUATION OF CORNER BASED ON HISTORIC WITNESSES & REPLACED IT WITH 3/4" BAR & ALUMINUM CAP.

C. Description of monument for corner and accessories established to perpetuate locating the position of the corner:

K-13  
3/4" X 24" BAR & 2 1/2" ALUMINUM CAP STAMPED PA 345 LS 25837 INGHAM COUNTY  
FOUND NAIL & TAG 25837, N. SIDE 36" MAPLE, 60° NAZ, 31.50'  
FOUND NAIL & TAG 25837, E. SIDE UTILITY POLE, 320° NAZ, 46.02'  
CENTERLINE, 40" TULIP POPLAR, 175°, 65.70'  
SET NAIL & TAG #25837, E. SIDE 27" OAK, 45° NAZ, 92.70'  
NE CORNER STONE FOUNDATION HOUSE, 195° NAZ, 83.50'

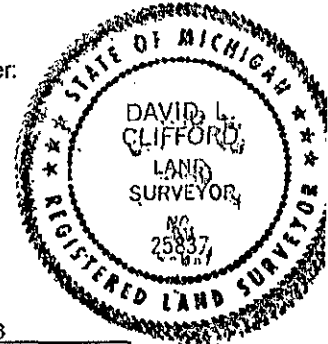

Signed by David L. Clifford  
Surveyor's Michigan License No. 25837

Date AUGUST 10, 1998

P.A. 345 INGHAM COUNTY  
PEER APPROVED 8/11/98 ML