SURVEY &
REMONUMENTATION

DEC 0 9 1999

SECTION

LAND CORNER RECORDATION CERTIFICATE
Filing Requirement of Act 74, Mich. P.A. 1970

For corners in

INGHAM COUNTY
(County)
WHITE OAK TOWNSHIP

		Located In:	Corner Code #
1. Public Land Survey		T 2N R 2E	L-4
		T___ R___	
		T___ R___	
		T___ R___	
Property Controlling	S___	T___ R___	
in Section	S___	T___ R___	
3.Miscellaneous	S___	T___ R___	
Property in Sec.	S___	T___ R___	

Paula Johnson
INGHAM COUNTY
REGISTER OF DEEDS RECORDED
ENGER SURVEYING & ENGINEERI CRNR 9.00

L-9 P-551
1999-060041

1999-060041
Page: 1 of 1
11/30/1999 09:48A

Register of Deeds Stamp & File Number

4. Lot No. _____ , Recorded Plat _____
5. Private Claims _____

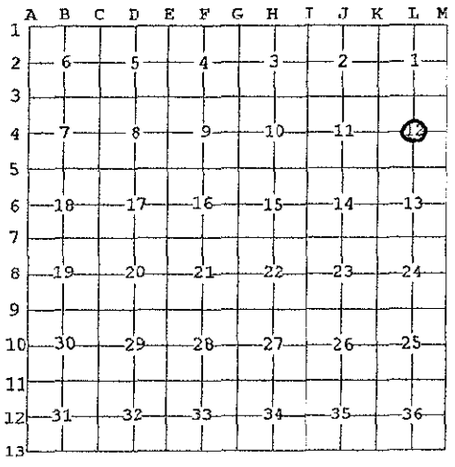

I, DAVID L. CLIFFORD, in a field survey on AUGUST, 30, 19 99 do hereby state that under requirements of P.A. 74, Michigan P.A. of 1970, the corner points mentioned in lines 1 and 2 above were in conformance with regulations and rules therefore as required in the current manual of survey instructions of the United States Department of the Interior, Bureau of Land Management or by a decree of a Court of Law and /or that the corner points mentioned in lines 3, 4 and 5 above were in conformance with the rules of the Michigan Board of Land Surveyors or by a Decree of a Court of Law; established, re-established, monumented, recovered, found as expressed below:

NOTE: Not more than 2 corners, all in the same town and range, may be recorded on this certificate.

A. Description of original monument and accessories and/or subsequent restoration:
1. CORNER NOT SET IN ORIGINAL GOVERNMENT SURVEY.

2. A. JACKSON, COUNTY SURVEYOR, SET CORNER IN A SURVEY RECORDED IN VOLUME 1 PAGE 149 IN NOVEMBER 1838 WITH NO MENTION OF MONUMENT: ELM 14", N43½W, 20 LKS; RO 24", S32W, 29 LKS.

3. RON ENGER, LPS #28409, USED CORNER IN AN ACT 132 SURVEY IN JANUARY 1999 AS A 5/8" BAR & CAP SET AT ANCIENT ANCHOR POST WHICH AGREED WITH OCCUPATION LINES OF ALIQUOT PART DIVISIONS OF JACKSONS 1838 SURVEY: N&T N. SIDE 20" POPLAR, AZ. 105°, 7.08'; N&T SW SIDE 6" HICKORY, AZ. 165°, 15.53'; N&T E. SIDE DBL. 24" OAK, AZ. 190°, 9.35'; N&T N. SIDE 30" R. OAK, AZ. 260°, 33.92'

B. Description of corner evidence found and/or method applied in restoring or reestablishing corner:

SEARCHED AT APPARENT LOCATION OF CORNER AND FOUND 5/8" BAR & CAP #28409 AT EAST-WEST- SOUTH FENCE INTERSECTION. BAR & CAP IS IN FAIR PROPORTION TO JACKSONS 1838 SURVEY. BAR & CAP IS 8' NORTH AND 2.6' WEST OF THE INTERSECTION OF 1/4 LINES. ACCEPTED 5/8" BAR & CAP AS PERPETUATION OF CORNER AND CAPPED IT WITH 2¼" ALUMINUM CAP. MEASURED WEST 2670.63' TO K-4. MEASURED NORTH 2691.09' TO L-3. MEASURED EAST 2670.65' TO M-4. MEASURED SOUTH 2650.15' TO L-5.

C. Description of monument for corner and accessories established to perpetuate locating the position of the corner:

L-4 T2N, R2E
5/8" X 24" REBAR WITH 2¼" ALUMINUM CAP IMPRINTED PA 345 INGHAM COUNTY 25837 IN ANCIENT ANCHOR POST
FOUND NAIL & TAG 28409 IN NORTH SIDE 20" BASSWOOD, S75°E, 7.08'
FOUND NAIL & TAG 28409 IN SW SIDE 6" HICKORY, S10°W, 15.53'
FOUND NAIL & TAG 28409 IN EAST SIDE 16" TWIN WHITE OAK, S10°W, 9.35'
FOUND NAIL & TAG 28409 IN SOUTH SIDE 30" RED OAK, S80°W, 33.92'

Signed by David Clifford Date SEPTEMBER 08,1999
Surveyor's Michigan License No. 25837

FORM APPROVED BY MICHIGAN STATE BOARD OF PROFESSIONAL SURVEYORS, JAN. 28, 1971
REVISED MAY 14,1975
REVISED JAN., 1983
REVISED OCT., 1995

STATE OF MICHIGAN
DAVID L. CLIFFORD
LAND SURVEYOR
NO. 25837
REGISTERED LAND SURVEYOR

P.A. 345 INGHAM COUNTY
PEER APPROVED 10/29/99 M