

SURVEY & REMONUMENTATION

DEC 09 1999

SECTION

LAND CORNER RECORDATION CERTIFICATE
Filing Requirement of Act 74, Mich. P.A. 1970

For corners in

INGHAM COUNTY Located In: _____ Corner Code # _____
(County)

WHITE OAK TOWNSHIP

1. Public Land Survey T 2N R R2E L-5
T _____ R _____
T _____ R _____
T _____ R _____

2. Property Controlling in Section S _____ T _____ R _____
S _____ T _____ R _____

3. Miscellaneous Property in Sec. S _____ T _____ R _____
S _____ T _____ R _____

4. Lot No. _____, Recorded Plat _____

5. Private Claims _____

Paula Johnson
INGHAM COUNTY REGISTER OF DEEDS RECORDED ENGER SURVEYING & ENGINEERING CRNR 9.00
L-9 P-552
1999-060042
1999-060042
Page: 1 of 1
11/30/1999 09:48A

Register of Deeds Stamp & File Number

I, DAVID L. CLIFFORD, in a field survey on AUG. 25, 1999 Do hereby state that under requirements of P.A. 74, Michigan P.A. of 1970, the corner points mentioned in lines 1 and 2 above were in conformance with regulations and rules therefore as required in the current manual of survey instructions of the United States Department of the Interior, Bureau of Land Management or by a decree of a Court of Law and for that the corner points mentioned in lines 3, 4 and 5 above were in conformance with the rules of the Michigan Board of Land Surveyors or by a Decree of a Court of Law, established, re-established, monumented, recovered, found as expressed below:


NOTE: Not more than 2 corners, all in the same town and range, may be recorded on this certificate.

	A	B	C	D	E	F	G	H	I	J	K	L	M
1													
2	6		5		4		3		2		1		
3													
4	7		8		9		10		11		12		
5													
6	18		17		16		15		14		13		
7													
8	19		20		21		22		23		24		
9													
10	30		29		28		27		26		25		
11													
12	31		32		33		34		35		36		
13													

- A. Description of original monument and accessories and/or subsequent restoration:
1. POST SET IN ORIGINAL GOVERNMENT SURVEY BY J. WAMPLER, D.S., IN NOV. 1825; ASH 8, N87E, 32 LKS; WILLOW 5, S38E, 21 LKS.
 2. A. JACKSON, COUNTY SURVEYOR USED CORNER IN A SURVEY RECORDED IN VOLUME 1 PAGE 149 IN NOV. 1838 IN THE INGHAM COUNTY SURVEYOR RECORDS WITH NO MENTION OF MONUMENT AND THE GLO WITNESSES.
 3. TJ BROWN, DEPUTY COUNTY SURVEYOR USED CORNER IN A SURVEY RECORDED IN VOLUME 3 PAGE 45 IN JUNE 1870 IN THE INGHAM COUNTY SURVEYOR RECORDS AS A POST: W. ASH 10", S60°W, 60 LKS; MAPLE 14", S37°E, 26½ LKS.
 4. O. BOSS RLS #13574 RECORDED CORNER IN LIBER 3 PAGE 529 IN FEB. 1976 AND USED IT IN AN ACT 132 SURVEY RECORDED IN LIBER 1 PAGES 1223-1226 AS A FOUND 1/2" IRON: NAIL IN SW SIDE 14" HICKORY, S33°E, 32.77"; NAIL IN EAST SIDE 14" OAK, S3°E, 68.50"; NAIL IN NW SIDE 14" OAK, N55°E, 80.15'.
 5. K. PIOTROWSKI RLS #9685 RECORDED CORNER IN LIBER 4 PAGE 72 IN JUNE 1977 AND USED IT IN AN ACT 132 SURVEY RECORDED IN LIBER 2 PAGE 390 IN OCT. 1975 AS A FOUND 1/2" REROD: 10" OAK, N45°E, 47.75'; 2" PIPE IN CENTER OF STONE PILLAR, NORTH, 24.60'; 15" NUT, S70°E, 76.76'.
 6. G. BOSS RLS #17022 USED CORNER IN AN ACT 132 SURVEY RECORDED IN LIBER 3 PAGE 680 IN DEC. 1978 WITH SAME MONUMENT AND WITNESSES AS ITEM 4 ABOVE.
 7. G. BOSS RLS #17022 USED CORNER AN ACT 132 SURVEY RECORDED IN LIBER 6 PAGE 262 IN JUNE 1990 AS A 1" BAR IN MONUMENT BOX: CAP N. SIDE 20" MAPLE, S12°E, 95.37'; ROAD SIGN POST, S65°W, 66.00'; SPIKE S. SIDE 30" OAK, N70°E, 80.75'; STEEL FENCE POST, N3°W, 33.1'.
 8. M. FOUTY RLS #18989 USED CORNER AN ACT 132 SURVEY RECORDED IN LIBER 5 PAGE 89 IN NOV. 1985 WITH SAME MONUMENT AND WITNESSES AS IN ITEM 5 ABOVE.

B. Description of corner evidence found and/or method applied in restoring or reestablishing corner:
SEARCHED AT APPARENT LOCATION OF CORNER AND FOUND ½" BAR 2' SOUTH OF CENTERLINE IOSCO ROAD ON FENCE LINE TO SOUTH AND OPPOSITE A STONE PILLAR TO NORTH. EXCAVATED 2' DIAMETER HOLE 4' DEEP TO NATURAL GROUND (BLACK MUCK). FOUND NO OTHER EVIDENCE OF POSITION OF CORNER. TRAVERSE OF SECTION REVEALS AN EXCELLENT PROPORTIONAL LOCATION OF IRON TO BROWNS 1870 SURVEY. ACCEPTED ½" BAR AS PERPETUATION OF CORNER AND REPLACED IT WITH 3/4" BAR & ALUMINUM CAP. MEASURED NORTH 2650.15' TO L-4. MEASURED EAST 2666.37' TO M-5. MEASURED WEST 2665.39' TO K-5.

C. Description of monument for corner and accessories established to perpetuate locating the position of the corner:
L-5 T2N-R2E
3/4" X 24" BAR WITH 2 1/2" ALUMINUM CAP STAMPED PA 345 25837 INGHAM COUNTY IN MONUMENT BOX
SET NAIL & TAG 28409 (RON ENGER), EAST SIDE 19" OAK, N18°E, 53.63'
SET NAIL & TAG 28409, SOUTH SIDE 15" OAK, N55°E, 48.00'
SET NAIL & TAG 28409, WEST SIDE 21" OAK, S30°E, 32.40'
SET NAIL & TAG 28409, EAST SIDE 52" OAK, S05°W, 99.75'
3" PIPE IN CENTER STONE PILLAR, N05°W, 24.75'
SET NAIL & TAG 28409, NORTH SIDE 22" OAK, S55°W, 51.80'

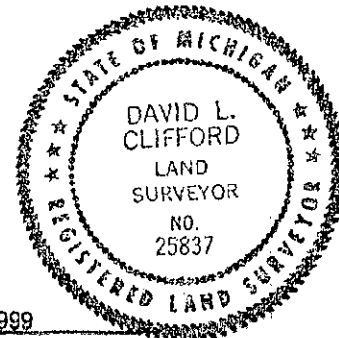

Signed by David Clifford
Surveyor's Michigan License No. 25837

Date SEPTEMBER 08, 1999