

SURVEY & REMONUMENTATION

DEC 09 1999

SECTION

LAND CORNER RECORDATION CERTIFICATE
Filing Requirement of Act 74, Mich. P.A. 1970

For corners in

<u>INGHAM COUNTY</u>	Located In:	Corner Code #
(County)		
<u>WHITE OAK TOWNSHIP</u>		
1. Public Land Survey	T <u>2N</u> R <u>2E</u>	<u>L-6</u>
	T ___ R ___	___
	T ___ R ___	___
	T ___ R ___	___
Property Controlling in Section	S ___ T ___ R ___	___
	S ___ T ___ R ___	___
3. Miscellaneous Property in Sec.	S ___ T ___ R ___	___
	S ___ T ___ R ___	___

Paula Johnson
INGHAM COUNTY REGISTER OF DEEDS RECORDED
ENGER SURVEYING & ENGINEERING CRNR 9.00
L-9 P-553
1999-060043



Register of Deeds Stamp & File Number

4. Lot No. _____, Recorded Plat _____
5. Private Claims _____

I, DAVID L. CLIFFORD, in a field survey on SEP 02, 1999 do hereby state that under requirements of P.A. 74, Michigan P.A. of 1970, the corner points mentioned in lines 1 and 2 above were in conformance with regulations and rules therefore as required in the current manual of survey instructions of the United States Department of the Interior, Bureau of Land Management or by a decree of a Court of Law and /or that the corner points mentioned in lines 3, 4 and 5 above were in conformance with the rules of the Michigan Board of Land Surveyors or by a Decree of a Court of Law; established, re-established, monumented, recovered, found as expressed below:

NOTE: Not more than 2 corners, all in the same town and range, may be recorded on this certificate.

	A	B	C	D	E	F	G	H	I	J	K	L	M
1													
2	6		5		4		3		2		1		
3													
4	7		8		9		10		11		12		
5													
6	18		17		16		15		14		13		
7													
8	19		20		21		22		23		24		
9													
10	30		29		28		27		26		25		
11													
12	31		32		33		34		35		36		
13													

A. Description of original monument and accessories and/or subsequent restoration:
1. CORNER NOT SET IN ORIGINAL GOVERNMENT SURVEY.

2. TJ BROWN, COUNTY SURVEYOR, SET CORNER IN A SURVEY RECORDED IN VOLUME 3 PAGE 45 IN JUNE 1870 AS A POST: HICKORY 10", S60W, 1 LK (.7"); R. OAK 20", N17W, 32½ LKS (21.5')

3. O. BOSS, RLS, 13574, RECORDED CORNER IN LIBER 3 PAGE 529 IN FEB. 1976 AND USED IT IN AN ACT 132 SURVEY RECORDED IN LIBER 1 PAGES 1223-1226 IN AUGUST 1973 AS A 1/2" IRON SET: NAIL W/S 20" HICKORY, N., 0.91"; NAIL W/S 10" OAK, WEST, 8.55'; NAIL SOUTH SIDE 20" OAK, SOUTH, 9.83'.


4. GARY BOSS, RLS, 17022, USED CORNER IN AN ACT 132 SURVEY RECORDED IN LIBER 6 PAGE 262 IN JUNE 1990 WITH SAME MONUMENT AND WITNESSES AS ITEM 3 ABOVE.

B. Description of corner evidence found and/or method applied in restoring or reestablishing corner:

SEARCHED AT APPARENT LOCATION OF CORNER AND FOUND 1/2" BAR WITH 3/4" PIPE STICKING UP 3' NEXT TO IT AT INTERSECTION ANCIENT NORTH-SOUTH AND EAST-WEST FENCES WITH BOSS'S WITNESS TO THE SOUTH STILL STANDING AND HIS OTHER 2 WITNESSES NOW STUMPS. THE BOSS HICKORY WITNESS IS ALSO BROWNS 1ST WITNESS AND IT IS LYING ON GROUND, BADLY ROTTED AND IT IS IMPOSSIBLE TO SAY WHERE IT STOOD WHEN ALIVE. EXCAVATED 5' DIAMETER HOLE 2' DEEP AND FOUND NOTHING BUT ROTTED TREE STUMP. BELIEVE THAT BROWNS CORNER POSITION LIES WITHIN THIS ROTTED STUMP AND THAT 1/2" BAR IS VERY CLOSE TO WHERE BROWN SET CORNER. BAR IS 2.4' NORTH AND 1.2' WEST OF INTERSECTION OF 1/4 LINES. ACCEPTED 1/2" BAR AS PERPETUATION OF CORNER AND REPLACED IT WITH 5/8" REBAR & ALUMINUM CAP. MEASURED WEST 2702.77' TO K-6. MEASURED NORTH 2662.45' TO L-5. MEASURED EAST 2703.86' TO M-6. MEASURED SOUTH 2635.96' TO L-7.

C. Description of monument for corner and accessories established to perpetuate locating the position of the corner:

L-6 T2N, R2E
5/8" X 24" BAR WITH 2¼" ALUMINUM CAP IMPRINTED PA 345 INGHAM COUNTY 25837
SET NAIL & TAG 28409 (RON ENGER) IN EAST SIDE 17" ASH, N08°W, 16.97'
SET NAIL & TAG 28409 IN SOUTH SIDE 19" ASH, N80°E, 46.27'
SET NAIL & TAG 28409 IN WEST SIDE 10" OAK, S15°E, 8.48'
SET NAIL & TAG 28409 IN NE SIDE 14" HICKORY, N80°W, 46.46'

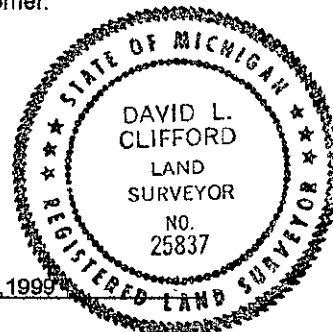

Signed by David Clifford
Surveyor's Michigan License No. 25837

Date SEPTEMBER 08, 1999