

SURVEY & REMONUMENTATION

DEC 9 1999

SECTION

LAND CORNER RECORDATION CERTIFICATE
Filing Requirement of Act 74, Mich. P.A. 1970

For corners in

INGHAM COUNTY Located In: _____ Corner Code # _____
(County)

WHITE OAK TOWNSHIP
1. Public Land Survey T 2N R 2E L-7
T _____ R _____
T _____ R _____
T _____ R _____

2. Property Controlling S _____ T _____ R _____
in Section T _____ R _____

3. Miscellaneous S _____ T _____ R _____
Property in Sec. S _____ T _____ R _____

Paula Johnson
INGHAM COUNTY REGISTER OF DEEDS RECORDED
ENGER SURVEYING & ENGINEERING CRNR 9.00 1999-060044

L-9 P-554



Register of Deeds Stamp & File Number

4. Lot No. _____, Recorded Plat _____
5. Private Claims _____

I, DAVID L. CLIFFORD, in a field survey on AUG. 26, 19 99 Do hereby state that under requirements of P.A. 74, Michigan P.A. of 1970, the corner points mentioned in lines 1 and 2 above were in conformance with regulations and rules therefore as required in the current manual of survey instructions of the United States Department of the Interior, Bureau of Land Management or by a decree of a Court of Law and /or that the corner points mentioned in lines 3, 4 and 5 above were in conformance with the rules of the Michigan Board of Land Surveyors or by a Decree of a Court of Law, established, re-established, monumented, recovered, found as expressed below.

NOTE: Not more than 2 corners, all in the same town and range, may be recorded on this certificate.

	A	B	C	D	E	F	G	H	I	J	K	L	M
1													
2	6			5			4			3		2	1
3													
4	7						8			9		10	11
5													
6	18			17			16			15		14	13
7													
8	19			20			21			22		23	24
9													
10	30			29			28			27		26	25
11													
12	31			32			33			34		35	36
13													

A. Description of original monument and accessories and/or subsequent restoration:

1. POST SET IN ORIGINAL GOVERNMENT SURVEY BY J. WAMPLER, D.S., IN NOV. 1825; WO 12", S88E, 6 LKS; WO 8", S19E, 18 LKS.
2. TJ BROWN, DEPUTY COUNTY SURVEYOR USED CORNER IN A SURVEY RECORDED IN VOLUME 3 PAGE 45 IN JUNE 1870 IN THE INGHAM COUNTY SURVEYOR RECORDS AS A POST: HICK. 3", N32°E, 39½ LKS; HICK. 3", S39°W, 35 LKS.
3. RJ ROBB, COUNTY SURVEYOR, USED CORNER IN A SURVEY RECORDED IN VOLUME 2 PAGE 256 IN JAN. 1907 IN THE INGHAM COUNTY SURVEYOR RECORDS AS AN STONE: HICK. 7", N6½°W, 39 LKS (25.7'); S.W. OAK 14", N67°W, 96 LKS (63.4')
4. INGHAM COUNTY ROAD COMMISSION CORNER GRID SHEET (1968): IRON; 20" OAK, N.E., 75.77'; 12" ASH, S.E., 21.41'; 20" OAK, S.W., 38.42'; 46" OAK, N.W., 63.74'
5. O. BOSS RLS #13574 RECORDED CORNER IN LIBER 2 PAGE 211 IN OCT. 1972 AND LIBER 3 PAGE 531 IN FEB. 1976 AND USED IT IN ACT 132 SURVEYS RECORDED IN LIBER 1 PAGES 712-714 AND LIBER 1 PAGES 1223-1227 IN AUGUST 1973 AS A FOUND 1/2" PIPE: NAIL IN E. SIDE 20" TREE, N2°E, 27.3'; NAIL IN S. SIDE 26" OAK, S65°W, 39.3'; NAIL IN E. SIDE 10" TREE, S21°E, 21.41'.
6. A. WILLIAMS RLS #21275 USED CORNER IN AN ACT 132 SURVEY RECORDED IN LIBER 3 PAGES 106 & 107 IN NOV. 1977 WITH NO MENTION OF MONUMENT OR WITNESSES.

B. Description of corner evidence found and/or method applied in restoring or reestablishing corner:


SEARCHED AT APPARENT LOCATION OF CORNER AND FOUND ½" PIPE ON CENTERLINE DANSVILLE ROAD ON FENCE LINE TO NORTH MATCHING ALL OF ROAD COMMISSION AND BOSS WITNESSES. ROBB'S WITNESSES STILL STAND AND CROSS 1' NORTH OF IRON. EXCAVATED 2' DIAMETER HOLE 4' DEEP TO NATURAL GROUND. FOUND 1½" PIPE DIRECTLY BENEATH 1/2" PIPE. TRAVERSE OF SECTION REVEALS AN EXCELLENT PROPORTIONAL LOCATION OF PIPE TO BROWNS 1870 SURVEY. ACCEPTED PIPES AS PERPETUATION OF CORNER AND RESET 1/2" PIPE ABOVE 1½" PIPE AND CAPPED IT WITH 2¼" ALUMINUM CAP. MEASURED EAST 2744.53' TO M-7. MEASURED WEST 2721.46' TO K-7.

C. Description of monument for corner and accessories established to perpetuate locating the position of the corner:

- L-7 T2N-R2E
1/2" X 24" PIPE WITH 2¼" ALUMINUM CAP STAMPED PA 345 25837 INGHAM COUNTY IN MONUMENT BOX
SET NAIL & TAG 28409 (RON ENGER), SOUTH SIDE 37" OAK, N75°E, 74.88'
SET NAIL & TAG 28409, EAST SIDE 17" HICKORY, S25°E, 21.55'
SET NAIL & TAG 28409, NORTH SIDE 21" OAK, S68°W, 38.55'
SET NAIL & TAG 28409, SOUTH SIDE 52" OAK, N65°W, 64.10'
SET NAIL & TAG 28409, EAST SIDE 19" HICKORY, N05°E, 27.02'

Signed by David Clifford
Surveyor's Michigan License No. 25837

Date SEPTEMBER 09, 1999

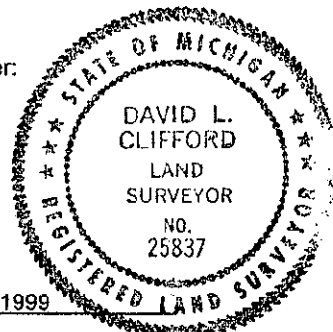

FORM APPROVED BY MICHIGAN STATE BOARD OF PROFESSIONAL SURVEYORS, JAN. 28, 1971
REVISED MAY 14, 1975
REVISED JAN, 1983
REVISED OCT, 1995

P.A. 345 INGHAM COUNTY
PEER APPROVED 10/29/99 *MC*