

DEC 09 1999

SECTION

LAND CORNER RECORDATION CERTIFICATE  
Filing Requirement of Act 74, Mich. P.A. 1970

For corners in

INGHAM COUNTY  
(County)

Located In:

Corner Code #

WHITE OAK TOWNSHIP  
1. Public Land Survey

T 2N R 2E  
T R  
T R  
T R  
S T R  
S T R  
S T R  
S T R

L-8

Paula Johnson  
INGHAM COUNTY  
REGISTER OF DEEDS  
REGISTERED  
ENGINEER SURVEYING & ENGINEERING

L-9 P-555

CRNR 9.00

1999-060045



1999-060045

Page: 1 of 1  
11/30/1999 09:48A

Property Controlling  
in Section  
3. Miscellaneous  
Property in Sec.

Register of Deeds Stamp & File Number

4. Lot No. \_\_\_\_\_, Recorded Plat \_\_\_\_\_  
5. Private Claims \_\_\_\_\_

I, DAVID L. CLIFFORD, in a field survey on OCT. 25, 1999 do hereby state that under requirements of P.A. 74, Michigan P.A. of 1970, the corner points mentioned in lines 1 and 2 above were in conformance with regulations and rules therefore as required in the current manual of survey instructions of the United States Department of the Interior, Bureau of Land Management or by a decree of a Court of Law and /or that the corner points mentioned in lines 3, 4 and 5 above were in conformance with the rules of the Michigan Board of Land Surveyors or by a Decree of a Court of Law; established, re-established, monumented, recovered, found as expressed below:

NOTE: Not more than 2 corners, all in the same town and range, may be recorded on this certificate.

	A	B	C	D	E	F	G	H	I	J	K	L	M
1													
2	6		5		4		3		2		1		
3													
4	7		8		9		10		11		12		
5													
6	18		17		16		15		14		13		
7													
8	19		20		21		22		23		24		
9													
10	30		29		28		27		26		25		
11													
12	31		32		33		34		35		36		
13													

A. Description of original monument and accessories and/or subsequent restoration:

1. CORNER NOT SET IN ORIGINAL GOVERNMENT SURVEY.

2. RJ ROBB, COUNTY SURVEYOR, SET CORNER IN A SURVEY RECORDED IN VOLUME 2 PAGE 256 IN JAN. 1908 AS AN IRON WITH NO MENTION OF WITNESSES.

3. O. BOSS, RLS #13574, RECORDED CORNER IN LIBER 2, PAGE 111, IN OCT. 1972 AND USED IT IN AN ACT 132 SURVEY RECORDED IN LIBER 1 PAGES 712-714 IN MAY 1973 AS A 1/2" PIPE FOUND: NAIL N/S 8" HICKORY, S62°W, 17.5'; NAIL W/S TREE, NORTH, 19.45'; NAIL NORTH SIDE 42" MAPLE, EAST, 16.25'.

4. C. GARLOCK, RLS, USED CORNER IN ACT 132 SURVEYS RECORDED IN LIBER 2, PAGE 278 IN FEB. 1975 AND LIBER 3 PAGE 210 IN JAN. 1978 WITH NO MENTION OF MONUMENT OR WITNESSES.

5. A. MILLER, RLS #12024, RECORDED CORNER IN LIBER 4, PAGE 127 IN FEB. 1972 AND USED IT IN AN ACT 132 SURVEY RECORDED IN LIBER 2 PAGES 1177-1180 IN JULY 1977 AS A FOUND 1/2" PIPE: NORTH, 19.60', NAIL/TAG IN 8" MAPLE; N80°W, NAIL/TAG IN 8" ASH; S75°W, 17.46', NAIL/TAG IN 10" OAK; N85°E, NAIL/TAG IN 40" MAPLE

B. Description of corner evidence found and/or method applied in restoring or reestablishing corner:


SEARCHED AT APPARENT LOCATION OF CORNER AND FOUND A 1/2" PIPE 3' SOUTH OF A NORTH-EAST-WEST FENCE CORNER MATCHING BOSS AND MILLER WITNESSES. EXCAVATED 3' DIAMETER HOLE 2' DEEP AND FOUND ANCIENT 1/4" PIPE AMID MANY STONES BELOW 1/2" PIPE. TRAVERSE OF SECTION SHOWS PIPES TO BE 2.5' NORTH AND 3.4' EAST OF INTERSECTION OF 1/4" LINES. ACCEPTED 1/2" PIPE AND 1/4" PIPE AS CORNER AND REPLACED 1/2" PIPE AND CAPPED IT WITH ALUMINUM CAP. MEASURED WEST 2711.21' TO K-8. MEASURED NORTH 2685.70' TO L-7. MEASURED EAST 2757.69' TO M-8. MEASURED SOUTH 2620.78' TO L-9.

C. Description of monument for corner and accessories established to perpetuate locating the position of the corner:

L-8 T2N, R2E  
1/2" X 24" PIPE WITH 2 1/4" ALUMINUM CAP IMPRINTED PA 345 INGHAM COUNTY 25837  
SET NAIL & TAG 28409 (RON ENGER) IN WEST SIDE 10" HICKORY, NORTH, 19.69'  
SET NAIL & TAG 28409 IN SOUTH SIDE 48" MAPLE, EAST, 17.54'  
SET NAIL & TAG 28409 IN WEST SIDE 8" HICKORY, S17°W, 25.75'  
SET NAIL & TAG 28409 IN NW SIDE 15" WHITE OAK, S65°W, 17.30'

Signed by David Clifford

Date OCTOBER 26, 1999

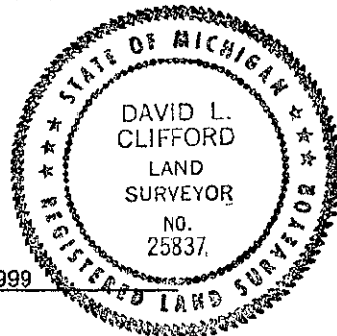

Surveyor's Michigan License No. 25837