

SURVEY & REMONUMENTATION

DEC 09 1999

SECTION

LAND CORNER RECORDATION CERTIFICATE
Filing Requirement of Act 74, Mich. P.A. 1970

For corners in

<u>INGHAM COUNTY</u>	Located In:	Corner Code #
(County)		
WHITE OAK TOWNSHIP	T <u>2N</u> R <u>2E</u>	<u>L-9</u>
1. Public Land Survey	T ___ R ___	___
	T ___ R ___	___
	T ___ R ___	___
2. Property Controlling in Section	S ___ T ___ R ___	___
	S ___ T ___ R ___	___
3. Miscellaneous Property in Sec.	S ___ T ___ R ___	___
	S ___ T ___ R ___	___

Paula Johnson
 INGHAM COUNTY REGISTER OF DEEDS RECORDED
 ENGER SURVEYING & ENGINEERING CRNR 9.00
L-9 P-556
 1999-060046



Register of Deeds Stamp & File Number

4. Lot No. _____, Recorded Plat _____
 5. Private Claims _____

I, DAVID L. CLIFFORD, in a field survey on AUG. 26, 1999 Do hereby state that under requirements of P.A. 74, Michigan P.A. of 1970, the corner points mentioned in lines 1 and 2 above were in conformance with regulations and rules therefore as required in the current manual of survey instructions of the United States Department of the Interior, Bureau of Land Management or by a decree of a Court of Law and /or that the corner points mentioned in lines 3, 4 and 5 above were in conformance with the rules of the Michigan Board of Land Surveyors or by a Decree of a Court of Law; established, re-established, monumented, recovered, found as expressed below:


NOTE: Not more than 2 corners, all in the same town and range, may be recorded on this certificate.

A	B	C	D	E	F	G	H	I	J	K	L	M
1												
2	6		5		4		3		2		1	
3												
4	7		8		9		10		11		12	
5												
6	18		17		16		15		14		13	
7												
8	19		20		21		22		23		24	
9												
10	30		29		28		27		26		25	
11												
12	31		32		33		34		35		36	
13												

- A. Description of original monument and accessories and/or subsequent restoration:
1. POST SET IN ORIGINAL GOVERNMENT SURVEY BY J. WAMPLER, D.S., IN NOV. 1825; RO 30", S3W, 26 LKS; WO 20", N7½E, 24 LKS.
 2. TJ BROWN, DEPUTY COUNTY SURVEYOR USED CORNER IN A SURVEY RECORDED IN VOLUME 2 PAGE 330 IN MAR. 1858 IN THE INGHAM COUNTY SURVEYOR RECORDS AS A POST WITH THE SAME WITNESSES AS RECORDED IN THE GLO NOTES.
 3. RJ ROBB, COUNTY SURVEYOR, USED CORNER IN A SURVEY RECORDED IN VOLUME 2 PAGE 256 IN JAN. 1907 IN THE INGHAM COUNTY SURVEYOR RECORDS AS A POST: HICK. 8", N40°E, 13½ LKS (8.9'); HICK. 10", N80°W, 20 LKS (13.2')
 4. G. YOUNG RLS #17640 RECORDED CORNER IN LIBER 3 PAGE 405 IN JULY 1975 AS A FOUND IRON WITH CAP IN ROTTED ANCHOR POST: NAIL IN 15" OAK, N10°E, 13.25'; NAIL IN 18" OAK, N80°E, 12.53'; NAIL IN 12" HICKORY, S75°W, 16.33'.
 5. C. GARLOCK RLS #14762 USED CORNER IN AN ACT 132 SURVEY RECORDED IN LIBER 3 PAGE 210 IN APR. 1977 WITH NO MENTION OF MONUMENT OR WITNESSES.
 6. A. MILLER RLS #12024 USED CORNER IN AN ACT 132 SURVEY RECORDED IN LIBER 2 PAGE 1177 IN JULY 1977 WITH NO MENTION OF MONUMENT OR WITNESSES.

B. Description of corner evidence found and/or method applied in restoring or reestablishing corner:
 SEARCHED AT APPARENT LOCATION OF CORNER AND FOUND ½" BAR & CAP #17640 IN OLD ANCHOR POST HOLE WITH ALL OF G. YOUNGS WITNESSES NOW STUMPS. ROBBS HICKORY WITNESS TO NE IS NOW A STUMP AND MEASURES WELL TO FOUND BAR & CAP. EXCAVATED 3' DIAMETER HOLE 2' DEEP AND FOUND ANCIENT 1½" PIPE ON NORTH SIDE OF ANCHOR POST REMAINS. TRAVERSE OF SECTIONS 13 & 24 REVEALS A GOOD PROPORTIONAL LOCATION OF BAR & CAP TO BROWNS 1858 SURVEY AND ROBB'S 1907 SURVEY. ACCEPTED BAR & CAP AS PERPETUATION OF CORNER AND SET 5/8" BAR & ALUMINUM CAP IN PLACE OF IT. MEASURED EAST 2710.47' TO M-9. MEASURED WEST 2690.68' TO K-9. MEASURED NORTH 2620.78' TO L-8. MEASURED SOUTH 2694.46' TO L-10.

C. Description of monument for corner and accessories established to perpetuate locating the position of the corner:
 L-9 T2N-R2E
 5/8" X 24" REBAR WITH 2½" ALUMINUM CAP STAMPED PA 345 25837 INGHAM COUNTY
 SET NAIL & TAG 28409 (RON ENGER), WEST SIDE 5" OAK, N22°E, 11.25'
 SET NAIL & TAG 28409, NE SIDE 5" MAPLE, S48°E, 10.65'
 SET NAIL & TAG 28409, SOUTH SIDE 21" OAK, S68°W, 79.08'
 SET NAIL & TAG 28409, EAST SIDE 17" OAK, N55°W, 75.43'

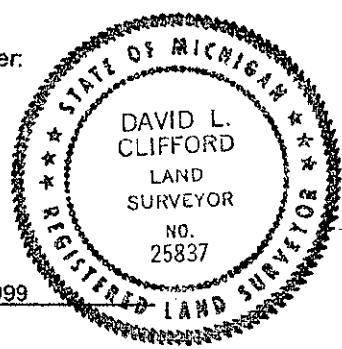

Signed by David Clifford

Date OCTOBER 26, 1999

Surveyor's Michigan License No. 25837

FORM APPROVED BY MICHIGAN STATE BOARD OF PROFESSIONAL SURVEYORS, JAN. 28, 1971
 REVISED MAY 14, 1975
 REVISED JAN, 1983
 REVISED OCT., 1996

P.A. 345 INGHAM COUNTY
 PEER APPROVED: 10/29/99 *mu*