

DEC 09 1999

SECTION

LAND CORNER RECORDATION CERTIFICATE
Filing Requirement of Act 74, Mich. P.A. 1970

For corners in

<u>INGHAM COUNTY</u> (County)	Located In:	Corner Code #
WHITE OAK TOWNSHIP	T <u>2N</u> R <u>2E</u>	<u>L-10</u>
1. Public Land Survey	T <u> </u> R <u> </u>	<u> </u>
	T <u> </u> R <u> </u>	<u> </u>
	T <u> </u> R <u> </u>	<u> </u>
Property Controlling in Section	S <u> </u> T <u> </u> R <u> </u>	<u> </u>
	S <u> </u> T <u> </u> R <u> </u>	<u> </u>
3. Miscellaneous Property in Sec.	S <u> </u> T <u> </u> R <u> </u>	<u> </u>
	S <u> </u> T <u> </u> R <u> </u>	<u> </u>

Paula Johnson
INGHAM COUNTY
REGISTER OF DEEDS RECORDED
ENGER SURVEYING & ENGINEERING ENGINEER CRNR 9.00
L-9 P-557
1999-060047



Register of Deeds Stamp & File Number

4. Lot No. _____, Recorded Plat _____
5. Private Claims _____

I, DAVID L. CLIFFORD, in a field survey on OCT. 25, 1999 do hereby state that under requirements of P.A. 74, Michigan P.A. of 1970, the corner points mentioned in lines 1 and 2 above were in conformance with regulations and rules therefore as required in the current manual of survey instructions of the United States Department of the Interior, Bureau of Land Management or by a decree of a Court of Law and for that the corner points mentioned in lines 3, 4 and 5 above were in conformance with the rules of the Michigan Board of Land Surveyors or by a Decree of a Court of Law; established, re-established, monumented, recovered, found as expressed below.

A	B	C	D	E	F	G	H	I	J	K	L	M
1												
2	6		5		4		3		2		1	
3												
4	7		8		9		10		11		12	
5												
6	18		17		16		15		14		13	
7												
8	19		20		21		22		23		24	
9												
10	30		29		28		27		26		25	
11												
12	31		32		33		34		35		36	
13												

NOTE: Not more than 2 corners, all in the same town and range, may be recorded on this certificate.

- A. Description of original monument and accessories and/or subsequent restoration:
- CORNER NOT SET IN ORIGINAL GOVERNMENT SURVEY.
 - TJ BROWN, COUNTY SURVEYOR, SET CORNER IN A SURVEY RECORDED IN VOLUME 2 PAGE 330 IN MARCH 1858 AS A POST IN MARSH NO TREES.
 - MILES BULLOCK, LIVINGSTON COUNTY SURVEYOR, SURVEYED THE WEST CEDAR EXTENSION DRAIN IN MARCH 1911 AND THE SURVEY OF SAID DRAIN STATES THAT THE CENTER OF SECTION 25 IS IN SAID DRAIN.
 - G. YOUNG, RLS, 17640, RECORDED CORNER IN LIBER 4 PAGE 118 IN DEC. 1977 BUT THE CORNER HE ACTUALLY RECORDED WAS L-10, T2N, R2W.


B. Description of corner evidence found and/or method applied in restoring or reestablishing corner:

SEARCHED AT APPARENT LOCATION OF CORNER AND FOUND A FENCE FROM THE EAST INTERSECTING THE WEST CEDAR EXTENSION DRAIN. EAST & WEST BANK OF DRAIN BOTH HAVE NORTH- SOUTH FENCES. LOCATED NORTH-SOUTH FENCE IN AREAS WHERE IT IS NOT AFFECTED BY DRAIN. FENCE ON WEST BANK OF DRAIN IS IN LINE WITH FENCE OUTSIDE OF DRAIN AREA TO NORTH & SOUTH. TRAVERSE OF SECTION SHOWS WEST FENCE TO BE VERY CLOSE TO NORTH-SOUTH 1/4 LINE. SEARCHED IN WEST FENCE ON EXTENSION OF FENCE FROM EAST AND FOUND VERY OLD ANCHOR POST HOLE IN FENCE ON WEST BANK OF DRAIN. ACCEPTED ANCHOR POST HOLE AS PERPETUATION OF CORNER AND SET 5/8" BAR WITH ALUMINUM CAP IN IT. CORNER IS 10.4' SOUTH AND 1.6' WEST OF INTERSECTION OF 1/4 LINES. MEASURED WEST 2661.64' TO K-10 (BROWN MEASURED 2655.8'). MEASURED NORTH 2693.67' TO L-9 (BROWN MEASURED 2667.72'). MEASURED EAST 2680.37' TO M-9 (BROWN MEASURED 2681.25'). MEASURED SOUTH 2640.37' TO L-11(BROWN MEASURED 2635.70').

- C. Description of monument for corner and accessories established to perpetuate locating the position of the corner:
- L-10 T2N, R2E
5/8" X 24" BAR WITH 2 1/4" ALUMINUM CAP IMPRINTED PA 345 INGHAM COUNTY 25837 IN ANCHOR POST HOLE
SET NAIL & TAG 28409 (RON ENGER) IN SW SIDE 14" ASH, S67°E, 30.52'
SET NAIL & TAG 28409 IN SE SIDE 15" WALNUT, N83°E, 29.24'
SET NAIL & TAG 28409 IN SE SIDE 15" WALNUT, N22°E, 70.32'
SET NAIL & TAG 28409 IN NORTH SIDE RR TIE FENCE POST, N89°E, 40.73'

Signed by David Clifford

Date OCTOBER 26, 1999

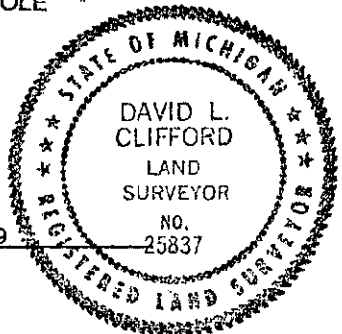

Surveyor's Michigan License No. 25837

P.A. 345 INGHAM COUNTY
PEER APPROVED 10/29/99 M