

DEC 17 1998

SECTION

LAND CORNER RECORDATION CERTIFICATE
Filing Requirement of Act 74, Mich. P.A. 1970

Liber 9 Page 425

For corners in

<u>INGHAM COUNTY</u> (County)	Located In:	Corner Code #
<u>WHITE OAK TOWNSHIP</u>		
1. Public Land Survey	<u>T 2N R 2E</u>	<u>L-13</u>
	T <u> </u> R <u> </u>	<u> </u>
	T <u> </u> R <u> </u>	<u> </u>
	T <u> </u> R <u> </u>	<u> </u>
2. Property Controlling in Section	S <u> </u> T <u> </u> R <u> </u>	<u> </u>
	S <u> </u> T <u> </u> R <u> </u>	<u> </u>
3. Miscellaneous Property in Sec.	S <u> </u> T <u> </u> R <u> </u>	<u> </u>
	S <u> </u> T <u> </u> R <u> </u>	<u> </u>

FILED

980061001
12/01/1998 09:36:16
REGISTER OF DEEDS
Paula Johnson
INGHAM COUNTY, MI

Register of Deeds Stamp & File Number

4. Lot No. _____, Recorded Plat _____
5. Private Claims _____

I, DAVID L. CLIFFORD, in a field survey on OCTOBER 12, 1998

Do hereby state that under requirements of P.A. 74, Michigan P.A. of 1970, the corner points mentioned in lines 1 and 2 above were in conformance with regulations and rules therefore as required in the current manual of survey instructions of the United States Department of the Interior, Bureau of Land Management or by a decree of a Court of Law and/or that the corner points mentioned in lines 3, 4 and 5 above were in conformance with the rules of the Michigan Board of Land Surveyors or by a Decree of a Court of Law, established, re-established, monumented, recovered, found as expressed below:

NOTE: Not more than 2 corners, all in the same town and range, may be recorded on this certificate.

	A	B	C	D	E	F	G	H	I	J	K	L	M
1													
2		6		5		4		3		2		1	
3													
4		7		8		9		10		11		12	
5													
6		18		17		16		15		14		13	
7													
8		19		20		21		22		23		24	
9													
10		30		29		28		27		26		25	
11													
12		31		32		33		34		35		36	
13													

A. Description of original monument and accessories and/or subsequent restoration:

1. JOSEPH WAMPLER D.S. SET POST IN ORIGINAL GOVERNMENT SURVEY IN JULY 1824; W.O. 12", N85 1/2°W, 40 LKS, W.O. 16", N53 1/2°E, 239 LKS.
2. T.J. BROWN, DEPUTY COUNTY SURVEYOR, USED CORNER IN A SURVEY RECORDED IN VOLUME 2 PAGE 329 IN JAN 1858 WITH NO MENTION OF MONUMENT OR WITNESSES.

B. Description of corner evidence found and/or method applied in restoring or reestablishing corner:


SEARCHED AT APPARENT LOCATION OF CORNER AND FOUND 1/2" BAR & CAP # 18989 (MARV FOUTY) IN NORTH-SOUTH FENCE ON FENCE LINE TO EAST MATCHING MAHIEU AND MOST RECENT BOSS WITNESSES FOR L-1 STOCKBRIDGE AS RECORDED IN LIBER 7 OF CORNERS PAGE 328 IN JULY 1997. TRAVERSE OF SECTION 36 WHITE OAK TOWNSHIP AND SECTION 1 STOCKBRIDGE TOWNSHIP REVEALED THAT BAR AND CAP IS 24' SOUTH OF TOWNSHIP LINE AND ON NORTH-SOUTH 1/4 LINE OF SECTION 1 OF STOCKBRIDGE TOWNSHIP. SEARCHED AT POINT 24' NORTH OF IRON AND FOUND ANCIENT REMAINS OF ANCHOR POST. SEARCHED WITH METAL DETECTOR AND FOUND REMNANTS OF FENCE EAST & WEST OF ANCIENT ANCHOR POST. TIED OCCUPATION EAST AND WEST OF CORNER AND FOUND THAT FENCE FROM EAST THAT ENDS AT FOUTY IRON IS NOT OLD AND IS EXTENSION OF SOUTH FENCE OF LANE THAT ENDS 660' EAST OF CORNER. NORTH FENCE OF LANE FALLS ON TOWNSHIP LINE. ACT 132 SURVEYS TO WEST IN STOCKBRIDGE TOWNSHIP SHOW DEFLECTION IN TOWNSHIP LINE 1230' WEST OF CORNER WHICH IS WHERE TOWNSHIP LINE OCCUPATION ENDS. MONUMENTATION OF THESE SURVEYS FALL WITHIN 1 FOOT OF THE ACTUAL TOWNSHIP LINE. EXCAVATED 10' DIAMETER HOLE CENTERED ON ANCIENT ANCHOR POST AND FOUND SINGLE FAN SHAPED REDDISH-WHITE STONE IN HOLE. NO OTHER EVIDENCE OF HISTORICAL CORNER FOUND. ACCEPTED ANCHOR POST AS L-1 STOCKBRIDGE AS ESTABLISHED BY T.J. BROWN IN LIBER 2 PAGE 335 IN JUNE 1858 AND SET STANDARD MONUMENT ON THE TOWNSHIP LINE IN THE ANCHOR POST HOLE. AS BROWN'S SURVEY OF JAN. 1858 SHOWED L-13 TO BE MIDWAY AND ON LINE BETWEEN THE STANDARD SECTION CORNERS SEARCHED IN OPEN HAY FIELD 44' WEST OF L-1 STOCKBRIDGE. FOUND NO EVIDENCE OF CORNER. FENCE FROM SOUTH CONTINUES NORTH ON NORTH-SOUTH 1/4 LINE OF SECTION 1 STOCKBRIDGE UNTIL ITS TERMINUS 1320' +/- NORTH OF TOWNSHIP LINE. AS THERE IS NO EVIDENCE OF CORNER SET STANDARD MONUMENT MIDWAY AND ON LINE BETWEEN STANDARD SECTION CORNERS. MEASURED EAST 2658.64' TO M-13. MEASURED WEST 2658.64' TO K-13.

C. Description of monument for corner and accessories established to perpetuate locating the position of the corner:

- L-13 T2N, R2E
 3/4" X 24' SMOOTH STEEL BAR WITH 2 1/2" ALUMINUM CAP STAMPED PA 345 INGHAM COUNTY 25837 IN OPEN HAY FIELD 2' BELOW GRADE
 SET NAIL & TAG #25837 WEST SIDE 26" HICKORY, S70°E, 50.08'
 SET NAIL & TAG #25837 NORTH SIDE 7" HICKORY, S80°E, 47.35'
 SET NAIL & TAG #25837 WEST SIDE 19" CHERRY, N82°E, 42.20'
 SET NAIL & TAG #25837 SE SIDE 6" HICKORY, N52°E, 35.74'
 1/2" BAR & CAP #18989 (IRON RECORDED AS L-1 STOCKBRIDGE IN LIBER 7 PAGE 328), S55°E, 51.05'
 3/4" X 24' SMOOTH STEEL BAR WITH 2 1/2" ALUMINUM CAP (L-1 T1N, R2E) EAST, 44.06'

Signed by David Clifford
Surveyor's Michigan License No. 25837

Date OCTOBER 19, 1998

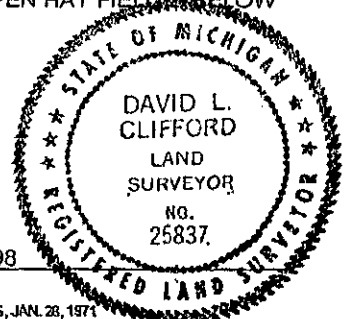

P.A. 345 INGHAM COUNTY
PEER APPROVED: 10/20/98 *MC*