

**SURVEY & REMONUMENTATION**

DEC 6 9 1999

Paula Johnson  
INGHAM COUNTY  
REGISTER OF DEEDS  
REGISTERED  
ENGINEER SURVEYING & ENGINEERING

L-9 P-501

CRNR 9.00

1999-050563

**LAND CORNER RECORDATION CERTIFICATE**  
Filing Requirement of Act 74, Mich. P.A. 1970

**SECTION**

For corners in

INGHAM COUNTY Located In: Corner Code #  
(County)  
WHITE OAK TOWNSHIP  
1. Public Land Survey T 2N R 2E M-2  
T \_\_\_ R \_\_\_  
T \_\_\_ R \_\_\_  
T \_\_\_ R \_\_\_  
2. Property Controlling S \_\_\_ T \_\_\_ R \_\_\_  
in Section  
S \_\_\_ T \_\_\_ R \_\_\_  
3. Miscellaneous T \_\_\_ R \_\_\_  
Property in Sec. S \_\_\_ T \_\_\_ R \_\_\_



1999-050563  
Page: 1 of 1  
10/08/1999 02:29P

Register of Deeds Stamp & File Number

4. Lot No. \_\_\_\_\_, Recorded Plat \_\_\_\_\_  
5. Private Claims \_\_\_\_\_

I, DAVID L. CLIFFORD, in a field survey on MAY 27, 1999 Do hereby state that under requirements of P.A. 74, Michigan P.A. of 1970, the corner points mentioned in lines 1 and 2 above were in conformance with regulations and rules therefore as required in the current manual of survey instructions of the United States Department of the Interior, Bureau of Land Management or by a decree of a Court of Law and for that the corner points mentioned in lines 3, 4 and 5 above were in conformance with the rules of the Michigan Board of Land Surveyors or by a Decree of a Court of Law, established, re-established, monumented, recovered, found as expressed below.

**NOTE: Not more than 2 corners, all in the same town and range, may be recorded on this certificate.**

	A	B	C	D	E	F	G	H	I	J	K	L	M
1													
2	6		5		4		3		2		1		
3													
4	7		8		9		10		11		12		
5													
6	18		17		16		15		14		13		
7													
8	19		20		21		22		23		24		
9													
10	30		29		28		27		26		25		
11													
12	31		32		33		34		35		36		
13													

A. Description of original monument and accessories and/or subsequent restoration:

1. POST SET IN ORIGINAL GOVERNMENT SURVEY BY J. WAMPLER, D.S., IN DEC. 1824; MAPLE 12, N35½W, 48 LKS; MAPLE 11, S62W, 51½ LKS.

2. A. JACKSON, COUNTY SURVEYOR, USED CORNER IN A SURVEY RECORDED IN VOLUME 1 PAGE 149, IN NOV. 1838 IN THE INGHAM COUNTY SURVEYOR RECORDS WITH THE SAME WITNESSES AS GLO.

3. THE INGHAM COUNTY REMONUMENTATION PROGRAM OF THE LATE 1970'S REPORTED A 10' X 10' EXCAVATION 3' DEEP OPPOSITE A FENCE LINE TO THE WEST ON THE CENTERLINE OF KANE ROAD, 87' FEET NORTH OF 1/2" BAR RECORDED IN LIVINGSTON COUNTY RECORDS AS A-2, T2N, R3E, ON MAY 1, 1979. A SECOND EXCAVATION OF 10' X 10' X 3' DEEP WAS REPORTED ON MAY 2, 1979. NO EVIDENCE OF CORNER WAS FOUND.


B. Description of corner evidence found and/or method applied in restoring or reestablishing corner:

SEARCHED AT APPARENT LOCATION OF CORNER AND FOUND NO EVIDENCE OF CORNER OR FENCE LINE MENTIONED IN ITEM A3 ABOVE. SET CORNER ON COUNTY LINE BY SINGLE PROPORTION MEASUREMENT BASED ON GLO MEASUREMENT. THIS POSITION LIES 86.8' NORTH OF A-2, T2N, R3E. AFTER SETTING MONUMENT SEARCHED TO WEST AND FOUND ANCHOR POST HOLE 25' WEST OF CORNER. THIS LOCATION ALSO AGREES EXACTLY WITH 1/8 LINE OCCUPATION 1/4 MILE NORTH BASED ON PROPORTIONATE MEASUREMENT OF JACKSON'S 1838 SURVEY. SET STANDARD BAR & ALUMINUM CAP. MEASURED NORTH 3507.74' TO M-1, T2N, R2E. MEASURED SOUTH 2656.19' TO M-3, T2N, R2E. MEASURED WEST 2666.12' TO L-2, T2N, R2E.

C. Description of monument for corner and accessories established to perpetuate locating the position of the corner:

M-2 T2N-R2E  
3/4" BAR AND 2 1/2" ALUMINUM CAP STAMPED PA 345 .25837 INGHAM COUNTY

SET NAIL & TAG 28409, EAST SIDE 7" HICKORY, N20°W, 72.00'  
SET NAIL & TAG 28409, EAST SIDE 8" HICKORY, N39°W, 37.80'  
SET NAIL & TAG 28409, SOUTH SIDE 14" HICKORY, WEST, 29.65'  
SW CORNER CONC. FOUNDATION HOUSE #288, N87°E, 137.85'  
1/2" BAR (A-2, T2N, R3E) SOUTH, 86.77'

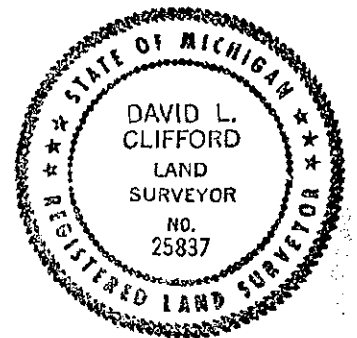

Signed by David Clifford

Date JULY 07, 1999

Surveyor's Michigan License No. 25837

FORM APPROVED BY MICHIGAN STATE BOARD OF PROFESSIONAL SURVEYORS, JAN. 28, 1971  
REVISED MAY 14, 1975  
REVISED JAN, 1983  
REVISED OCT, 1996

P.A. 345 INGHAM COUNTY  
PEER APPROVED 8/17/99 PC