

**SURVEY & REMONUMENTATION**

DEC 6 9 1999

**SECTION**

**LAND CORNER RECORDATION CERTIFICATE**  
Filing Requirement of Act 74, Mich. P.A. 1970

For corners in

INGHAM COUNTY Located In: \_\_\_\_\_ Corner Code # \_\_\_\_\_  
(County)  
WHITE OAK TOWNSHIP  
1. Public Land Survey T 2N R 2E M-5  
T \_\_\_\_\_ R \_\_\_\_\_  
T \_\_\_\_\_ R \_\_\_\_\_  
T \_\_\_\_\_ R \_\_\_\_\_  
2. Property Controlling S \_\_\_\_\_ T \_\_\_\_\_ R \_\_\_\_\_  
in Section T \_\_\_\_\_ R \_\_\_\_\_  
3. Miscellaneous S \_\_\_\_\_ T \_\_\_\_\_ R \_\_\_\_\_  
Property in Sec. S \_\_\_\_\_ T \_\_\_\_\_ R \_\_\_\_\_

Paula Johnson  
INGHAM COUNTY  
REGISTER OF DEEDS RECORDED  
ENGINEER SURVEYING & ENGINEER CRNR 9.00  
**L-9 P-559**  
1999-060049



1999-060049  
Page: 1 of 1  
11/30/1999 09:48A

Register of Deeds Stamp & File Number

4. Lot No. \_\_\_\_\_, Recorded Plat \_\_\_\_\_  
5. Private Claims \_\_\_\_\_

	A	B	C	D	E	F	G	H	I	J	K	L	M
1													
2	6		5		4		3		2		1		
3													
4	7		8		9		10		11		12		
5													
6	18		17		16		15		14		13		
7													
8	19		20		21		22		23		24		
9													
10	30		29		28		27		26		25		
11													
12	31		32		33		34		35		36		
13													

I, DAVID L. CLIFFORD, in a field survey on AUGUST 24, 1999 Do hereby state that under requirements of P.A. 74, Michigan P.A. of 1970, the corner points mentioned in lines 1 and 2 above were in conformance with regulations and rules therefore as required in the current manual of survey instructions of the United States Department of the Interior, Bureau of Land Management or by a decree of a Court of Law and /or that the corner points mentioned in lines 3, 4 and 5 above were in conformance with the rules of the Michigan Board of Land Surveyors or by a Decree of a Court of Law; established, re-established, monumented, recovered, found as expressed below:

**NOTE: Not more than 2 corners, all in the same town and range, may be recorded on this certificate.**

**A. Description of original monument and accessories and/or subsequent restoration:**

1. POST SET IN ORIGINAL GOVERNMENT SURVEY BY J. WAMPLER, D.S., IN DEC. 1824; ASH 9", N33 1/2 W, 44 LKS; ASH 11", S72 W, 92 LKS.
2. TJ BROWN, COUNTY SURVEYOR USED CORNER IN A SURVEY RECORDED IN VOLUME 2 PAGE 367 IN JAN. 1860 IN THE INGHAM COUNTY SURVEYOR RECORDS AS A POST ORDERED STONE SET FOR CORNER.
3. R. LESTER, RLS #18998, RECORDED CORNER IN LIBER 5 PAGE 256 DURING THE INGHAM COUNTY REMONUMENTATION PROGRAM OF THE LATE 1970'S IN JULY 1979. HE REPORTED FINDING A 1 1/2" X 1/2" BOLT, A 11 1/2" X 6-3/4" ROCK AND PIECES OF BROKEN CHINA DURING A 10' X 10' EXCAVATION. HE SET A 4" X 36" CONCRETE MONUMENT WITH 1/2" REROD & CAP # 18998 IN PLACE OF THIS EVIDENCE: NAIL & TAG #18998 WEST SIDE 20" WALNUT NE, 62.41'; NAIL & TAG #18998, NE SIDE 36" OAK, SE, 92.56'; NAIL & TAG #18998 NE SIDE 36" MAPLE, NW, 44.94'; NAIL & TAG #18998 SOUTH SIDE 32" MAPLE, WNW, 95.74'.


**B. Description of corner evidence found and/or method applied in restoring or reestablishing corner:**

SEARCHED AT APPARENT LOCATION OF CORNER AND FOUND 4" CONCRETE MONUMENT WITH 1/2" BAR MATCHING 3 REMAINING LESTER WITNESSES. ACCEPTED CONCRETE MONUMENT AS PERPETUATION OF CORNER CAPPED IT WITH 2 1/2" ALUMINUM CAP. MEASURED NORTH 2636.61' TO M-4. MEASURED WEST 2666.37' TO L-5. MEASURED SOUTH 2654.38' TO M-6.

**C. Description of monument for corner and accessories established to perpetuate locating the position of the corner:**

M-5 T2N-R2E  
4" CONCRETE MONUMENT WITH 1/2" BAR AND 2 1/2" ALUMINUM CAP STAMPED PA 345 25837 INGHAM COUNTY

- FOUND NAIL & BOSS ENGINEERING TAG, WEST SIDE 28" WALNUT, N20°E, 62.72'
- FOUND NAIL & TAG #18998, NE SIDE 40" OAK, S31°E, 92.43'
- CENTERLINE 10" MAPLE, S78°W, 117.10'
- FOUND NAIL & TAG #18998, SOUTH SIDE 38" MAPLE, N73°W, 95.75'
- SET NAIL & TAG #25837, EAST SIDE 14" OAK, N25°W, 82.50'
- 1/2" PIPE (A-5, T2N, R3E) SOUTH, 114.92' (108.90' GLO)

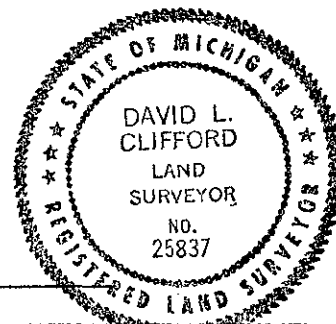

Signed by David Clifford  
Surveyor's Michigan License No. 25837

Date SEP 09, 1999

FORM APPROVED BY MICHIGAN STATE BOARD OF PROFESSIONAL SURVEYORS, APR. 28, 1971  
REVISED MAY 14, 1975  
REVISED JAN. 1983  
REVISED OCT., 1996

P.A. 345 INGHAM COUNTY  
PEER APPROVED 10/29/99 M