

DEC 09 1999

SECTION

LAND CORNER RECORDATION CERTIFICATE
Filing Requirement of Act 74, Mich. P.A. 1970

For corners in

INGHAM COUNTY	Located In:	Corner Code #
(County)		
WHITE OAK TOWNSHIP		
1. Public Land Survey	T <u>2N</u> R <u>2E</u>	<u>M-6</u>
	T ___ R ___	___
	T ___ R ___	___
	T ___ R ___	___
2. Property Controlling in Section	S ___ T ___ R ___	___
	S ___ T ___ R ___	___
3. Miscellaneous Property in Sec.	S ___ T ___ R ___	___
	S ___ T ___ R ___	___

Paula Johnson
 INGHAM COUNTY REGISTER OF DEEDS RECORDED
 ENGER SURVEYING & ENGINEERING CRNR 9.00
 L-9 P-560
 1999-060050



Register of Deeds Stamp & File Number

4. Lot No. _____, Recorded Plat _____
 5. Private Claims _____

A	B	C	D	E	F	G	H	I	J	K	L	M
1												
2	6	5	4	3	2	1						
3												
4	7	8	9	10	11	12						
5												
6	16	17	16	15	14	13						
7												
8	19	20	21	22	23	24						
9												
10	30	29	28	27	26	25						
11												
12	31	32	33	34	35	36						
13												

I, DAVID L. CLIFFORD, in a field survey on AUGUST 24, 1999 Do hereby state that under requirements of P.A. 74, Michigan P.A. of 1970, the corner points mentioned in lines 1 and 2 above were in conformance with regulations and rules therefore as required in the current manual of survey instructions of the United States Department of the Interior, Bureau of Land Management or by a decree of a Court of Law and/or that the corner points mentioned in lines 3, 4 and 5 above were in conformance with the rules of the Michigan Board of Land Surveyors or by a Decree of a Court of Law; established, re-established, monumented, recovered, found as expressed below:

NOTE: Not more than 2 corners, all in the same town and range, may be recorded on this certificate.

A. Description of original monument and accessories and/or subsequent restoration:

1. POST SET IN ORIGINAL GOVERNMENT SURVEY BY J. WAMPLER, D.S., IN DEC. 1824; ELM 14", N14½W, 41½ LKS; HICK. 7", S36W, 45 LKS.
2. TJ BROWN, COUNTY SURVEYOR USED CORNER IN A SURVEY RECORDED IN VOLUME 2 PAGE 367 IN JAN. 1860 IN THE INGHAM COUNTY SURVEYOR RECORDS AS A POST: HICK. 5", N27W, 110 LKS; YELLOW OAK 4", N57E, 80½ LKS.
3. R. LESTER, RLS #18998, RECORDED CORNER IN LIBER 5 PAGE 236 DURING THE INGHAM COUNTY REMONUMENTATION PROGRAM OF THE LATE 1970'S IN APRIL 1979. HE REPORTED FINDING SEVERAL SMALL STONES IN AN X PATTERN AND ONE LARGE STONE (1' X 2") WITH FLAT SIDE UP DIRECTLY UNDER CENTER OF X. HE SET A 4" X 36" CONCRETE MONUMENT WITH 1/2" BAR & CAP # 18998: NAIL & TAG #18998 SE SIDE 36" OAK, SW, 28.77'; NAIL & TAG #18998, NORTH SIDE 14" HICKORY, WNW, 24.90'; NAIL & TAG #18998 SOUTH SIDE 10" HICKORY, ENE, 26.20'; NAIL & TAG #18998 SW SIDE 11" OAK, SE, 38.39'.


B. Description of corner evidence found and/or method applied in restoring or reestablishing corner:

SEARCHED AT APPARENT LOCATION OF CORNER AND FOUND 4" CONCRETE MONUMENT WITH 1/2" BAR MATCHING 3 REMAINING LESTER WITNESSES. ACCEPTED MONUMENT AS CORNER AS PERPETUATED BY R. LESTER. REMOVED TOP 6" OF CONCRETE AND TOP 7" OF BAR AND CAPPED IT WITH 2½" ALUMINUM CAP. MEASURED NORTH 2654.38' TO M-5. MEASURED SOUTH 2656.92' TO M-7

C. Description of monument for corner and accessories established to perpetuate locating the position of the corner:

M-6 T2N-R2E
 4" CONCRETE MONUMENT WITH 1/2" BAR AND 2½" ALUMINUM CAP STAMPED PA 345 25837 INGHAM COUNTY

- FOUND NAIL & BOSS ENGINEERING TAG, SW SIDE 14" OAK, S40°E, 38.53'
- FOUND NAIL & BOSS ENGINEERING TAG, SE SIDE 40" OAK, S45°W, 28.60'
- SET NAIL & TAG # 25837, NW SIDE 12" HICKORY, N45°E, 31.90'
- SET NAIL & TAG # 25837, NE SIDE 12" HICKORY, N52°W, 56.80'
- SET NAIL & TAG #25837, EAST SIDE 14" OAK, N25°W, 82.50'

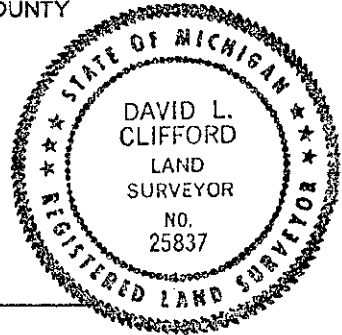

Signed by David Clifford

Date SEP. 09, 1999

Surveyor's Michigan License No. 25837

P.A. 345 INGHAM COUNTY
 PEER APPROVED: 10/29/99 MC