

DEC 9 1999

SECTION

LAND CORNER RECORDATION CERTIFICATE
Filing Requirement of Act 74, Mich. P.A. 1970

For corners in

<u>INGHAM COUNTY</u> <small>(County)</small>	Located in:	Corner Code #
WHITE OAK TOWNSHIP	T <u>2N</u> R <u>2E</u>	<u>M-7</u>
1. Public Land Survey	T ___ R ___	_____
	T ___ R ___	_____
	T ___ R ___	_____
2. Property Controlling in Section	S ___ T ___ R ___	_____
	S ___ T ___ R ___	_____
3. Miscellaneous Property in Sec.	S ___ T ___ R ___	_____

Paula Johnson
INGHAM COUNTY
REGISTER OF DEEDS RECORDED
ENGINEER SURVEYING & ENGINEER CRNR 9.00
1999-060051

L-9 P-561



Register of Deeds Stamp & File Number

4. Lot No. _____, Recorded Plat _____
5. Private Claims _____

I, DAVID L. CLIFFORD, in a field survey on AUGUST 24, 1999 Do hereby state that under requirements of P.A. 74, Michigan P.A. of 1970, the corner points mentioned in lines 1 and 2 above were in conformance with regulations and rules therefore as required in the current manual of survey instructions of the United States Department of the Interior, Bureau of Land Management or by a decree of a Court of Law and for that the corner points mentioned in lines 3, 4 and 5 above were in conformance with the rules of the Michigan Board of Land Surveyors or by a Decree of a Court of Law, established, re-established, monumented, recovered, found as expressed below:

NOTE: Not more than 2 corners, all in the same town and range, may be recorded on this certificate.

A	B	C	D	E	F	G	H	I	J	K	L	M
1												
2	6		5		4		3		2		1	
3												
4	7		8		9		10		11		12	
5												
6	18		17		16		15		14		13	
7												
8	19		20		21		22		23		24	
9												
10	30		29		28		27		26		25	
11												
12	31		32		33		34		35		36	
13												

A. Description of original monument and accessories and/or subsequent restoration:
 1. POST SET IN ORIGINAL GOVERNMENT SURVEY BY J. WAMPLER, D.S., IN DEC. 1824; W.O. 13", N29½W, 20 LKS; W.O. 19", S55W, 21½ LKS.
 2. TJ BROWN, COUNTY SURVEYOR USED CORNER IN A SURVEY RECORDED IN VOLUME 2 PAGE 367 IN JAN. 1860 IN THE INGHAM COUNTY SURVEYOR RECORDS AS A POST IN CENTER OF ROAD: W.O. 17", N3¼W, 62 LKS.
 3. O. BOSS, RLS #13574, RECORDED CORNER IN LIBER 2 PAGE 111 IN OCT. 1972 AND USED IT IN AN ACT 132 SURVEY RECORDED IN LIBER 1 PAGE 712-714 AS A FOUND 1/2" IRON NAIL, SOUTH SIDE 26" HICKORY, N67°W, 76.92'; NAIL, EAST SIDE 24" HICKORY, S14°W, 112.6'; NAIL, WEST SIDE 18" OAK, S50°E, 39.14'; NAIL, TOP 36" STUMP, WEST, 33.14'.
 4. A. WILLIAMS, RLS 21275, USED CORNER IN AN ACT 132 SURVEY RECORDED IN LIBER 3 PAGES 106 & 107 IN NOV. 1977 WITH NO MENTION OF MONUMENT OR WITNESSES.


B. Description of corner evidence found and/or method applied in restoring or reestablishing corner:

SEARCHED AT APPARENT LOCATION OF CORNER AND FOUND 1/2" BAR ON CENTERLINE KANE ROAD AND DANSVILLE ROAD MATCHING 3 REMAINING BOSS WITNESSES. EXCAVATED 4' SQUARE HOLE 3' DEEP THROUGH 2' OF ROAD GRAVEL. FOUND NO FURTHER EVIDENCE OF CORNER. TRAVERSE OF SECTIONS 13 AND 24 REVEAL AN EXCELLENT PROPORTIONAL RELATIONSHIP BETWEEN 1/2" BAR AND GLO MEASUREMENTS AND BROWNS 1860 SURVEY. ACCEPTED 1/2" BAR AS BEST EVIDENCE OF CORNER AND REPLACED IT WITH 3/4" X 24" REBAR AND 2¼" ALUMINUM CAP. MEASURED NORTH 2656.92' TO M-6. MEASURED SOUTH 2656.75' TO M-8. MEASURED WEST 2744.53' TO L-7.

C. Description of monument for corner and accessories established to perpetuate locating the position of the corner:

M-7 T2N-R2E
3/4" X 24" REBAR AND 2¼" ALUMINUM CAP STAMPED PA 345 25837 INGHAM COUNTY

FOUND NAIL & BOSS ENGINEERING TAG, WEST SIDE 23" OAK, N15°E, 86.27'
 FOUND NAIL & BOSS ENGINEERING TAG, WEST SIDE 29" OAK, S48°E, 39.18'
 FOUND NAIL & BOSS ENGINEERING TAG, EAST SIDE 25" HICKORY, S10°W, 112.30'
 FOUND NAIL & BOSS ENGINEERING TAG, SOUTH SIDE 26" HICKORY, N65°W, 77.20'
 SET NAIL & TAG #25837, EAST SIDE 29" HICKORY, N16°W, 110.35'

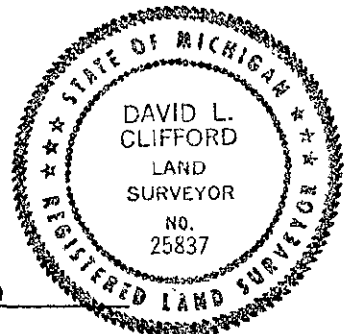

Signed by David Clifford
 Surveyor's Michigan License No. 25837

Date SEP. 09, 1999

P.A. 345 INGHAM COUNTY
 PEER APPROVED 10/29/99 *ML*