

SURVEY & REMONUMENTATION

DEC 8 1999

SECTION

LAND CORNER RECORDATION CERTIFICATE
Filing Requirement of Act 74, Mich. P.A. 1970

For corners in

INGHAM COUNTY Located in: _____ Corner Code # _____
(County)
WHITE OAK TOWNSHIP
1. Public Land Survey T 2N R 2E M-8
T _____ R _____
T _____ R _____
T _____ R _____
2. Property Controlling S _____ T _____ R _____
in Section S _____ T _____ R _____
3. Miscellaneous _____ T _____ R _____
Property in Sec. S _____ T _____ R _____

Paula Johnson
INGHAM COUNTY REGISTER OF DEEDS RECORDED
ENGINEER SURVEYING & ENGINEER CRNR 9.00
L-9 P-562
1999-060052



1999-060052
Page: 1 of 1
11/30/1999 09:48A

Register of Deeds Stamp & File Number

4. Lot No. _____, Recorded Plat _____
5. Private Claims _____

I, DAVID L. CLIFFORD, in a field survey on AUGUST 24, 1999. Do hereby state that under requirements of P.A. 74, Michigan P.A. of 1970, the corner points mentioned in lines 1 and 2 above were in conformance with regulations and rules therefore as required in the current manual of survey instructions of the United States Department of the Interior, Bureau of Land Management or by a decree of a Court of Law and /or that the corner points mentioned in lines 3, 4 and 5 above were in conformance with the rules of the Michigan Board of Land Surveyors or by a Decree of a Court of Law, established, re-established, monumented, recovered, found as expressed below:

NOTE: Not more than 2 corners, all in the same town and range, may be recorded on this certificate.

	A	B	C	D	E	F	G	H	I	J	K	L	M
1													
2		6		5		4		3		2		1	
3													
4		7		8		9		10		11		12	
5													
6		18		17		16		15		14		13	
7													
8		19		20		21		22		23		24	
9													
10		30		29		28		27		26		25	
11													
12		31		32		33		34		35		36	
13													

A. Description of original monument and accessories and/or subsequent restoration:


1. POST SET IN ORIGINAL GOVERNMENT SURVEY BY J. WAMPLER, D.S., IN DEC. 1824; HICK. 8", N16W, 69 LKS; W.O. 30", S59 1/2 W, 256 LKS.
2. RJ ROBB, COUNTY SURVEYOR USED CORNER IN A SURVEY RECORDED IN VOLUME 2 PAGE 256 IN JAN. 1907 IN THE INGHAM COUNTY SURVEYOR RECORDS AS A STONE: Y. OAK 18", N8°E, 153 1/2 LKS (101.3'); Y. OAK (DOUBLE), S49 1/2 E, 79 LKS (52.1')
3. O. BOSS, RLS #13574, RECORDED CORNER IN LIBER 2 PAGE 111 IN OCT. 1972 AND USED IT IN AN ACT 132 SURVEY RECORDED IN LIBER 1 PAGE 712-714 AS A FOUND 1/2" IRON: NAIL, SOUTH SIDE 14" TWIN HICKORY, N49°W, 24.35'; NAIL, NORTH SIDE 30" MAPLE, S59°W, 36.0'; NAIL, WEST SIDE 10" MAPLE, S26°E, 39.55'; 1/2" IRON, WEST, 33.14'
4. C. GARLOCK, RLS 14762, USED CORNER IN AN ACT 132 SURVEY RECORDED IN LIBER 2 PAGE 278 IN FEB. 1975 WITH SAME MONUMENT AND WITNESSES AS ITEM 3 ABOVE.

B. Description of corner evidence found and/or method applied in restoring or reestablishing corner:

SEARCHED AT APPARENT LOCATION OF CORNER AND FOUND 1/2" BAR ON CENTERLINE KANE ROAD MATCHING BOSS WITNESSES AND ROBB'S Y. OAK WITNESS TO THE NE. DID NOT EXCAVATE FOR STONE BECAUSE OF A 4' ROAD CUT AT THIS LOCATION. ACCEPTED 1/2" BAR AS BEST EVIDENCE OF CORNER BASED ON ROBB'S HISTORICAL WITNESS AND REPLACED IT WITH 5/8" X 24" REBAR AND 2 1/4" ALUMINUM CAP. MEASURED NORTH 2656.75' TO M-7. MEASURED SOUTH 2636.75' TO M-9.

C. Description of monument for corner and accessories established to perpetuate locating the position of the corner:

M-8 T2N-R2E
5/8" X 24" REBAR AND 2 1/4" ALUMINUM CAP STAMPED PA 345 25837 INGHAM COUNTY
FOUND NAIL & BOSS ENGINEERING TAG, NORTH SIDE 8" MAPLE, S80°E, 19.90'
FOUND NAIL & BOSS ENGINEERING TAG, SW SIDE 16" MAPLE, S25°E, 39.68'
FOUND NAIL & BOSS ENGINEERING TAG, SE SIDE 21" MAPLE, S45°W, 36.15'
FOUND NAIL & BOSS ENGINEERING TAG, SW SIDE 18" TWIN HICKORY, N50°W, 24.35'
SET NAIL & TAG #28409, WEST SIDE 50" YELLOW OAK, N10°E, 102.0' (ROBB WITNESS)

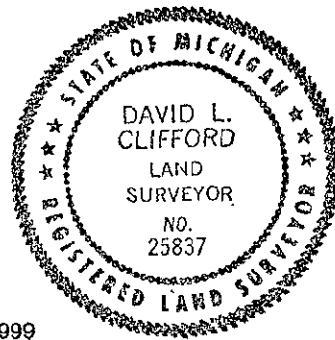

Signed by David Clifford

Date SEP. 09, 1999

Surveyor's Michigan License No. 25837

P.A. 345 INGHAM COUNTY
PEER APPROVED 10/29/99 M