

SURVEY &
REMONUMENTATION

DEC 16 1996

COMMISSION LAND CORNER RECORDATION CERTIFICATE
Filing Requirement of Act 74, Mich. P.A. 1970

Liber 9 Page 125

For corners in
INGHAM
(County)
AURELIUS TOWNSHIP

Located In: Corner Code #

1. Public Land Survey	T	<u>2N</u>	R	<u>2W</u>	<u>A-11</u>	
	T	_____	R	_____	_____	
	T	_____	R	_____	_____	
	T	_____	R	_____	_____	
2. Property Controlling in Section	S	_____	T	_____	R	_____
	S	_____	T	_____	R	_____
3. Miscellaneous Property in Sec.	S	_____	T	_____	R	_____
	S	_____	T	_____	R	_____

FILED

960046036
12/03/1996 13:22:55
REGISTER OF DEEDS
Paula Johnson
INGHAM COUNTY, MI

Register of Deeds Stamp & File Number

4. Lot No. _____, Recorded Plat _____
5. Private Claims _____

	A	B	C	D	E	F	G	H	I	J	K	L	I
2	6	5	4	3	2	1							
3													
4	7	8	9	10	11	12							
5													
6	18	17	16	15	14	13							
7													
8	19	20	21	22	23	24							
9													
10	30	29	28	27	26	25							
11	31	32	33	34	35	36							
12													
13													

I, DAVID L. CLIFFORD, in a field survey on AUGUST 22, 1996, do hereby certify that under requirements of P.A. 74, Michigan P.A. of 1970, the corner points mentioned in lines 1 and 2 above were in conformance with regulations and rules therefore as required in the current manual of survey instructions of the United States Department of the Interior, Bureau of Land Management or by a decree of a Court of Law and/or that the corner points mentioned in lines 3, 4 and 5 above were in conformance with the rules of the Michigan Board of Land Surveyors or by a Decree of a Court of Law, established, re-established, monumented, re-monumented, recovered, found as expressed below:

NOTE: Not more than 4 corners, all in the same town and range, may be recorded on this certificate.

A. Description of original monument and accessories and/or subsequent restoration:

- POST SET IN ORIGINAL GOVERNMENT SURVEY BY HERVEY PARKE, DEPUTY SURVEYOR, IN FEBRUARY 1826 "INTERSECTED WEST BOUNDARY 93 LINKS (61.4') SOUTH OF POST" AND TWO BEARING TREES RECORDED:
W. OAK 20" N26 E 64 LKS (42.2')
B. OAK 8" S31E 28½ LKS (18.8')


CONTINUED ON BACK

B. Description of corner evidence found and/or method applied in restoring or reestablishing corner:

SEARCHED AT APPARENT LOCATION OF CORNER AND FOUND 3/4" PIPE AND CAP #11370 IN MONUMENT BOX ON CENTERLINE OF WAVERLY ROAD AND CENTERLINE OF BARNES ROAD TO EAST. ACCEPTED PIPE AND CAP AS CORNER AS PERPETUATED BY DICK STEADMAN IN 1973 ON ACT 74 CERTIFICATE RECORDED IN LIBER 2 PAGE 637 AND CAPPED PIPE WITH PA 345 CAP LS 28409 AND 20D SPIKE.

C. Description of monument for corner and accessories established to perpetuate locating the position of the corner:

- A-11 T2N R2W
3/4" DIAMETER PIPE AND CAP IMPRINTED "PA 345 PS 28409" IN MONUMENT BOX.
NAIL AND TAG 28414 IN EAST SIDE OF 28" HICK., 342° NAZ., 102.48'
NAIL AND TAG 28414 IN WEST SIDE OF 36" OAK, 40° NAZ., 57.90'
NAIL AND TAG 28409 IN WEST SIDE OF 6" WALNUT, 158° NAZ., 88.95'
NAIL AND TAG 28414 IN EAST SIDE OF 30" OAK, 196° NAZ., 132.25'
3/4" PIPE & CAP #11370 IN MONUMENT BOX (M-11 T2N R3W), 02° NAZ., 61.05'

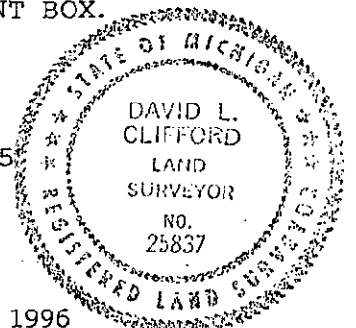

Signed by David L. Clifford
25837

Date SEPTEMBER 28, 1996

Surveyor's Michigan License No. _____

P.A. 345 INGHAM COUNTY
PEER APPROVED 10/17/96 *PC*

A-11 T2N R2W
PART A CONTINUED

2. A. JACKSON, COUNTY SURVEYOR, USED CORNER IN MARCH 1839 IN A SURVEY RECORDED IN VOLUME 1, PAGE 40 WITH THE SAME WITNESSES AS A-1 AND NO DESCRIPTION OF MONUMENT
3. A. JACKSON, COUNTY SURVEYOR, USED CORNER IN FEBRUARY 1841 IN A SURVEY RECORDED IN VOLUME 1, PAGE 45 WITH THE FOLLOWING WITNESSES:
 - B. OAK 8" S31E 28½ LKS (18.8')
 - R. OAK 22" N32W 51½ LKS (34.0')
4. R.J. ROBB, COUNTY SURVEYOR, MAKES REFERENCE TO THE CORNER IN A SURVEY RECORDED IN VOLUME 2, PAGE 272 ABOUT 1910 BUT DESCRIBES CONDITIONS FOUND AT A-13
5. R. W. STEADMAN, PS 11370, RECORDED CORNER IN LIBER 2, PAGE 637 IN JAN. 1974 A SET 3/4" PIPE AND MONUMENT BOX ON TOP OF A STONE AND CROCKERY FOUND BY EXCAVATION:
NAIL AND TAG IN 20" HICKORY ESE 97.36'
NAIL AND TAG IN 34" OAK NE 56.82'
NAIL AND TAG IN 18" HICKORY NNW 102.50'
CORNER COMMON TO SECTIONS 25 & 36, T2N, R3W (3/4" PIPE & CAP OVER STONE) NORTH, 61.09'
6. J. SELLEK, LS 2585, USED CORNER IN AN ACT 132 SURVEY IN JULY 1983 RECORDED IN LIBER 4 PAGES 922, 923, 924, AND 926 WITH THE SAME MONUMENT AND WITNESSES AS IN ITEM A-5.
7. F. WHITE, LS 12034, USED CORNER IN AN ACT 132 SURVEY IN JUNE 1985 RECORDED IN LIBER 4 PAGES 1147 & 1148 WITH A REFERENCE TO L.2, P.637.
6. K. FLUKE, LS 18988, USED CORNER IN AN ACT 132 SURVEY IN MARCH 1985 RECORDED IN LIBER 5 PAGE 21 WITH THE SAME MONUMENT AND WITNESSES AS IN ITEM A-5.