

**SURVEY &
REMONUMENTATION**

DEC 1 6 1996

COMMISSION

**LAND CORNER RECORDATION CERTIFICATE
Filing Requirement of Act 74, Mich. P.A. 1970**

Liber 9 Page 123

For corners in
INGHAM

(County)
AURELIUS TOWNSHIP

Located In: Corner Code #

1. Public Land Survey	T	<u>2N</u>	R	<u>2W</u>	<u>A-12</u>	
	T	_____	R	_____	_____	
	T	_____	R	_____	_____	
	T	_____	R	_____	_____	
2. Property Controlling in Section	S	_____	T	_____	R	_____
	S	_____	T	_____	R	_____
3. Miscellaneous Property in Sec.	S	_____	T	_____	R	_____
	S	_____	T	_____	R	_____

4. Lot No. _____, Recorded Plat _____
5. Private Claims _____

FILED

960046035
12/03/1996 13:22:53
REGISTER OF DEEDS
Paula Johnson
INGHAM COUNTY, MI

Register of Deeds Stamp & File Number

I, DAVID L. CLIFFORD, in a field survey on SEPTEMBER 24, 1996, do hereby certify that under requirements of P.A. 74, Michigan P.A. of 1970, the corner points mentioned in lines 1 and 2 above were in conformance with regulations and rules therefore as required in the current manual of survey instructions of the United States Department of the Interior, Bureau of Land Management or by a decree of a Court of Law and/or that the corner points mentioned in lines 3, 4 and 5 above were in conformance with the rules of the Michigan Board of Land Surveyors or by a Decree of a Court of Law; established, re-established, monumented, re-monumented, recovered, found as expressed below:

	A	B	C	D	E	F	G	H	I	J	K	L	I
2	6		5		4		3		2		1		
3													
4	7		8		9		10		11		12		
5													
6	18		17		16		15		14		13		
7													
8	19		20		21		22		23		24		
9													
10	30		29		28		27		26		25		
11													
12	31		32		33		34		35		36		
13													

NOTE: Not more than 4 corners, all in the same town and range, may be recorded on this certificate.


A. Description of original monument and accessories and/or subsequent restoration:

- POST NOT SET IN ORIGINAL GOVERNMENT SURVEY
- A. JACKSON, COUNTY SURVEYOR ESTABLISHED CORNER IN MARCH 1839 IN A SURVEY RECORDED IN VOLUME 1 PAGE 40 COUNTY SURVEYORS RECORDS WITH THE FOLLOWING WITNESSES:
ELM 14" S52 1/4 W 196 LKS
HICK. 12" S16 3/4 W 183 LKS

CONTINUED ON BACK

B. Description of corner evidence found and/or method applied in restoring or reestablishing corner:

SEARCHED AT APPARENT LOCATION OF CORNER AND FOUND 3/4" PIPE AND CAP #11370 IN MONUMENT BOX ONE FOOT EAST OF WEST EDGE WAVERLY ROAD ON FENCELINE TO EAST. ACCEPTED PIPE AND CAP AS CORNER AS PERPETUATED BY DICK STEADMAN IN 1973 ON ACT 74 CERTIFICATE RECORDED IN LIBER 2 PAGE 639 AND CAPPED PIPE WITH YELLOW PLASTIC CAP IMPRINTED PA 345 LS 28409

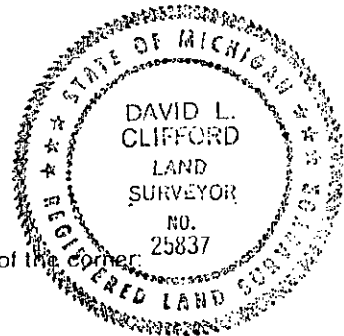

C. Description of monument for corner and accessories established to perpetuate locating the position of the corner:

- A-12 T2N R2W
3/4" DIAMETER PIPE AND CAP IMPRINTED "PA 345 PS 28409" IN MONUMENT BOX.
NAIL AND TAG 28414 IN SOUTH SIDE OF 14" POPLAR, 286° NAZ., 16.10'
NAIL AND TAG 28409 IN TOP SAWED OFF POWER POLE FENCE POST, 95° NAZ., 47.90'
NAIL AND TAG 28409 IN EAST SIDE OF 8" WALNUT, 193° NAZ., 124.83'
PUNCH MARK IN WEST END 12" CMP, 24° NAZ., 43.33'
PUNCH MARK IN EAST END 12" CMP, 140° NAZ., 56.85'
3/4" PIPE & CAP #11370 IN MONUMENT BOX (M-12 T2N R3W), 0° NAZ., 27.10'

Signed by David L. Clifford Date OCTOBER 12, 1996

Surveyor's Michigan License No. 25837

P.A. 345 INGHAM COUNTY
PEER APPROVED 10/17/96 *re*

A-12 T2N R2W
PART A CONTINUED

5. R. W. STEADMAN, PS 11370, RECORDED CORNER IN LIBER 2, PAGE 639 IN JAN. 1974 A SET 3/4" PIPE AND MONUMENT BOX ON TOWNSHIP LINE OPPOSITE FENCE LINE TO EAST IN MIDST OF LARGE QUANTITY OF BROKEN BRICK, CROCKERY, AND GLASS FOUND BY EXCAVATION:
NAIL AND TAG IN POWER POLE WSW 80.47'
3/4" IRON PIPE: ESE - 56.53'
M-12, T2N, R3W (3/4" PIPE & CAP OVER STONE) NORTH, 27.11'

6. J. SELLEK, LS 2585, USED CORNER IN AN ACT 132 SURVEY IN JULY 1983 RECORDED IN LIBER 4 PAGES 922, 923, 924, AND 926 WITH THE SAME MONUMENT AND WITNESSES AS IN ITEM A-5.

7. F. WHITE, LS 12034, USED CORNER IN AN ACT 132 SURVEY IN JUNE 1985 RECORDED IN LIBER 4 PAGES 1147 & 1148 WITH A REFERENCE TO L.2, P.639.

6. R. STEADMAN REFERS TO CORNER ON THE PLAT OF WAVERLY PLAINS RECORDED IN LIBER 47 OF PLATS PAGES 35 & 36 IN OCTOBER 1992 WITH A REFERENCE TO LIBER 2 PAGE 639