

Survey &  
REMONUMENTATION

DEC 16 1996

LAND CORNER RECORDATION CERTIFICATE  
Filing Requirement of Act 74, Mich. P.A. 1970

Liber 9 Page 119

COMMISSION

For corners in  
INGHAM

	Located In:	Corner Code #
(County) AURELIUS TOWNSHIP		
1. Public Land Survey	T 2N R 2W	A-13
ONONDAGA TOWNSHIP	T 1N R 2W	A-1
	T R	
	T R	
2. Property Controlling	S T R	
in Section	S T R	
3. Miscellaneous	S T R	
Property in Sec.	S T R	

FILED

960046033  
12/03/1996 13:22:50  
REGISTER OF DEEDS  
Paula Johnson  
INGHAM COUNTY, MI

Register of Deeds Stamp & File Number

4. Lot No. \_\_\_\_\_, Recorded Plat \_\_\_\_\_  
5. Private Claims \_\_\_\_\_

	A	B	C	D	E	F	G	H	I	J	K	L	M
2	6		5		4		3		2		1		
3													
4	7		8		9		10		11		12		
5													
6	18		17		16		15		14		13		
7													
8	19		20		21		22		23		24		
9													
10	30		29		28		27		26		25		
11													
12	31		32		33		34		35		36		
13													

DAVID L. CLIFFORD, in a field survey on OCTOBER 1, 1996

do hereby certify that under requirements of P.A. 74, Michigan P.A. of 1970, the corner points mentioned in lines 1 and 2 above were in conformance with regulations and rules therefore as required in the current manual of survey instructions of the United States Department of the Interior, Bureau of Land Management or by a decree of a Court of Law and/or that the corner points mentioned in lines 3, 4 and 5 above were in conformance with the rules of the Michigan Board of Land Surveyors or by a Decree of a Court of Law; established, re-established, monumented, re-monumented, recovered, found as expressed below:

NOTE: Not more than 4 corners, all in the same town and range, may be recorded on this certificate.

A. Description of original monument and accessories and/or subsequent restoration: *A-13 Aurelius T2N, R2W*

- POST SET IN ORIGINAL GOVERNMENT SURVEY BY JOHN MULLETT, DEPUTY SURVEYOR, IN MAY 1825 "INTERSECTED RANGE LINE 83 LINKS (54.8') NORTH OF TEMP POST, SET POST COMMON TO T'S 1 & 2N, R'S 2 & 3 W" AND TWO BEARING TREES RECORDED:  
W. OAK 10" S82W 398 LKS (262.7')  
B. OAK 9" N63½E 289 LKS (190.7')


CONTINUED ON BACK

B. Description of corner evidence found and/or method applied in restoring or reestablishing corner:

SEARCHED AT APPARENT LOCATION OF CORNER AND FOUND 5/8" BAR IN MONUMENT BOX ON CENTERLINE OF PLAINS ROAD AND 3' WEST OF CENTERLINE OF WAVERLY ROAD. EXCAVATED THROUGH BOTTOM OF MONUMENT BOX AND FOUND STONE WITH "+" IN THE TOP OF IT DIRECTLY UNDER THE BAR. THE STONE MATCHES WITNESSES OF ITEMS A-3 THROUGH A-9. ACCEPTED 5/8" BAR & STONE AS CORNER AS PERPETUATED BY EVERYONE LISTED IN PART A AND CAPPED 5/8" ROD WITH YELLOW PLASTIC CAP IMPRINTED PA 345 PS 25837.

C. Description of monument for corner and accessories established to perpetuate locating the position of the corner:

- A-11 T2N R2W  
5/8" X 15" STEEL BAR & YELLOW PLASTIC CAP IMPRINTED PA 345 PS 25837 OVER STONE IN MONUMENT BOX.  
NAIL AND TAG 28409 IN WEST SIDE OF 22" WALNUT., 170° NAZ., 111.90'  
NAIL AND TAG 17640 IN SE SIDE OF 24" PINE, 254° NAZ., 84.40'  
NAIL AND TAG 17640 IN SE SIDE OF 18" PINE (DEAD), 313° NAZ., 48.10'  
NAIL AND TAG 17640 IN NE SIDE OF 14" WALNUT, 334° NAZ., 50.90'  
NAIL AND TAG 17640 IN SE SIDE OF 30" SPRUCE, 53° NAZ., 54.01'  
SW CORNER FOUNDATION OF SCHOOL HOUSE, 52° NAZ., 101.85'

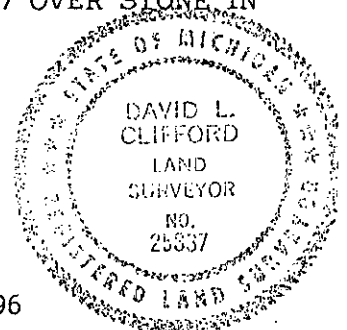

Signed by David L. Clifford  
25837

OCTOBER 14, 1996

Date

Surveyor's Michigan License No. \_\_\_\_\_

P.A. 345 INGHAM COUNTY  
PEER APPROVED 10/17/96 M

A-13 T2N R2W  
PART A CONTINUED

2. A. JACKSON, COUNTY SURVEYOR, USED CORNER IN MARCH 1839 IN A SURVEY RECORDED IN VOLUME 1, PAGE 40 WITH THE SECOND GLO WITNESS AND 1 NEW WITNESS: ELM 8" S45½E 33LKS (21.8') AND NO DESCRIPTION OF MONUMENT
3. R.J. ROBB, COUNTY SURVEYOR, MAKES REFERENCE TO THE CORNER IN A SURVEY RECORDED IN VOLUME 2, PAGE 272 ABOUT 1910. HE THEN CROSSED OUT THE WITNESSES AND ATTRIBUTED THEM TO A-11 BUT DESCRIBES CONDITIONS AS FOUND AT A-13 PRESENTLY:  
STONE  
SPRUCE 6" NW 49'  
SPRUCE 12" NE 54'  
SPRUCE 12" SE 64.5'
4. H. A. WILLIAMS, EATON COUNTY SURVEYOR, (IN A MARGINAL NOTE IN THE EATON COUNTY ROAD COMMISSION COPY OF THE GLO NOTES DATED MARCH 1921) CALLS FOR A STONE WITH + WITH THE FOLLOWING WITNESSES:  
8" SPRUCE N52°W 49'  
12" SPRUCE N63½°E 66'  
S.W. CORNER SCHOOL HOUSE N46°E 101'
5. EATON COUNTY ROAD COMMISSION CORNER GRID MAP CALLS FOR SAME MONUMENT AND WITNESSES AS A-4
6. INGHAM COUNTY ROAD COMMISSION CORNER GRID MAP CALLS FOR 5/8" IRON & BRICK OVER STONE(1971)  
30" PINE NE 54.18'  
30" PINE SE 65.53'  
16" PINE NW 48.89'
7. RONNIE M. LESTER PS 18998 RECORDED CORNER IN LIBER 1 OF CORNERS PAGE 102 EATON COUNTY RECORDS WITH THE SAME MONUMENT AND WITNESSES (PK NAILS IN WITNESSES) AS ITEM A-6
8. JIM STEPHENS PS 16053 RECORDED CORNER IN LIBER 2 OF CORNERS PG 511 IN OCTOBER 1973 AND REFERS TO CORNER IN SURVEYS RECORDED IN LIBER 1 OF SURVEYS PAGES 821-823, 830, 831 AND LIBER 5 OF SURVEYS PAGES 348 & 349 AS A 3/4" IRON BAR:  
SURVEY TAG SE SIDE 24" PINE, N52°W, 47.98'  
SURVEY TAG WEST SIDE 30" PINE, S63°E, 64.51'  
SURVEY TAG SW SIDE 36" PINE, N47°E, 53.12'
9. MAURICE MAHIEU PS 28414 USED CORNER IN SURVEYS RECORDED IN LIBER 5 OF SURVEYS PAGE 1119 WITH NO MENTION OF MONUMENT AND THE FOLLOWING WITNESSES:  
NAIL & TAG 17640 SE FACE 36" PINE N45°E 54.05'  
NAIL & TAG 17640 NE FACE 24" WALNUT N45°W 50.94'  
NAIL & TAG 17640 SE FACE 36" PINE N55°E 84.43'  
NAIL & TAG 17640 E FACE 28" WALNUT N30°W 80.24'
10. R.W. STEADMAN PS 11370 REFERS TO CORNER ON PLAT OF WAVERLY PLAINS RECORDED IN LIBER 47 OF PLATS PAGES 35 & 36 INGHAM COUNTY RECORDS WITH A REFERENCE TO LIBER 2 PAGE 511